

MISSISSIPPI DEPARTMENT OF NATURAL RESOURCES

Bureau of Land and Water Resources

Southport Mall

P.O. Box 10631

Jackson, Mississippi 39209

WATER WELL DRILLERS LOG

Date  
C 2070

3/85 1981 Bob Smith Tate  
date well completed firm name county well located

LANDOWNER:

Robert Harrison  
Independence, Mo  
(mailing address)

description of formations encountered

from to

top soil	0	5
gravel	5	70
white clay	70	140
red sand	140	160

WELL LOCATION:

sec 36 T 4 N R 6 E  
 2 miles E of dad  
 (distance) (direction) (nearest town)

WELL PURPOSE:

home, irrigation, municipal, industrial

WELL COMPLETION DATA:

- (1) diameter (inches) 4 1/2
- (2) total depth (feet) 160'
- (3) static water level (feet) 90' below top of ground.
- (4) casing plastic, 160'  
(material) (depth)

\_\_\_\_\_ If telescope see back.  
(size)

- (5) screen 20', 140'  
(length) (depth to top)  
4 1/2", plastic  
(size) (material)

- (6) pump 1/2, 10  
(HP) (yield gpm)

elec  
(type power)

- (7) electric log (yes or no)

\_\_\_\_\_ (organization running log)

- (8) how well bottom plugged cap

DRILLERS REMARKS:


DEPT. OF NATURAL RESOURCES  
BUREAU OF LAND & WATER RESOURCES

OCT 12 1982

RECEIVED

If well telescopes please sketch and show depths.

GROUND LEVEL

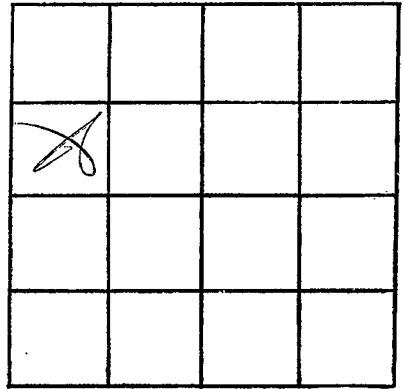

SECTION \_\_\_\_\_

Please indicate well location X.

ADDITIONAL INFORMATION

If more than one screen,  
show locations of each on sketch.