

MISSISSIPPI DEPARTMENT OF NATURAL RESOURCES

Bureau of Land and Water Resources

Southport Mall

P.O. Box 10631

Jackson, Mississippi 39209

WATER WELL DRILLERS LOG

Date
 8-20-81

8-15-81 19
 date well completed

Bob Smith
 firm name

State
 county well located

LANDOWNER:
 Malcolm Biley
 Independence, Mo.
 (mailing address)

description of formations encountered	from	to
top soil	0	5
red clay	5	90
gravel	90	120
white clay	120	170
course sand	170	180

WELL LOCATION:
 sec. 7 T 4 N R 6 E
 7 miles W. of ~~Independence~~
 (distance) (direction) (nearest town)

WELL PURPOSE:
 (home, irrigation, municipal, industrial)


- WELL COMPLETION DATA:
- (1) diameter (inches) 4"
 - (2) total depth (feet) 180'
 - (3) static water level (feet) 85' (below above top of ground.)
 - (4) casing plastic 180' (material) (depth)
 - if telescope see back. (size)
 - (5) screen 10' 170' (length) (depth to top)
 - 4" plastic (size) (material)
 - (6) pump 3/4 15 (HP) (yield gpm)
 - elec. (type power)
 - (7) electric log (yes or no)
 - (organization running log)
 - (8) how well bottom plugged Cap

DRILLERS REMARKS:

DEPT. OF NATURAL RESOURCES
 BUREAU OF LAND & WATER RESOURCES
 OCT 12 1982
 RECEIVED

If well telescopes please sketch and show depths.

GROUND LEVEL

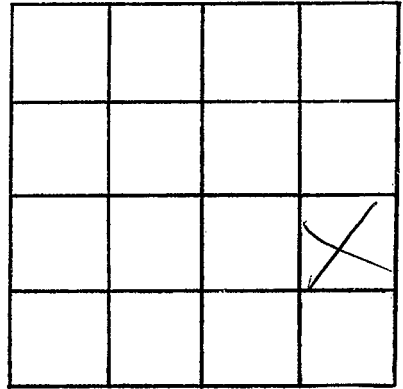

SECTION _____

Please indicate well location X.

ADDITIONAL INFORMATION

If more than one screen,
show locations of each on sketch.