

MISSISSIPPI DEPARTMENT OF NATURAL RESOURCES

Bureau of Land and Water Resources

Southport Mall

P.O. Box 10631

Jackson, Mississippi 39209

WATER WELL DRILLERS LOG

Date
 9-14-72

9-14 date well completed
 A. B. Smith firm name
 State county well located

LANDOWNER:

Bluight Lane
 Independence
 (mailing address)

description of formations encountered

from to

top soil	0	5
red clay	5	25
gravel	25	130
sand	130	125

WELL LOCATION:

sec. 26 T 4 N R 6 E
 3 miles E of Independence
 (distance) (direction) (nearest town)

WELL PURPOSE:

(home, irrigation, municipal, industrial)

WELL COMPLETION DATA:

- (1) diameter (inches) 4"
- (2) total depth (feet) 175'
- (3) static water level (feet) 70' below top of ground.
- (4) casing plastic, 175' (material) (depth)
- (size) if telescope see back.
- (5) screen 10' length, 165' depth to top
- 4" plastic (size) (material)
- (6) pump 1/2 HP, 10 (yield gpm)
- elec. (type power)
- (7) electric log (yes or no)
- (organization running log)
- (8) how well bottom plugged Cap

DRILLERS REMARKS:


DEPT. OF NATURAL RESOURCES
 BUREAU OF LAND & WATER RESOURCES

OCT 12 1982

RECEIVED

If well telescopes please sketch and show depths.

GROUND LEVEL

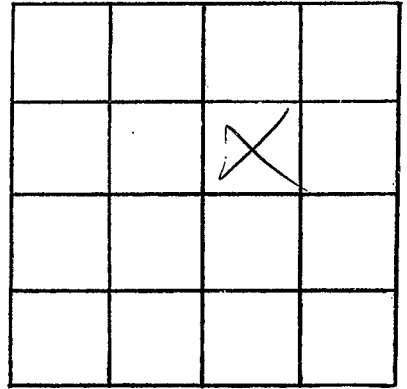

SECTION _____

Please indicate well location X.

ADDITIONAL INFORMATION

If more than one screen,
show locations of each on sketch.