

MISSISSIPPI DEPARTMENT OF NATURAL RESOURCES

Bureau of Land and Water Resources

Southport Mall

P.O. Box 10631


Jackson, Mississippi 39209

WATER WELL DRILLERS LOG

Late
C2003
6-29-81


6-29 19 81 Hicks Well Co. Late
 date well completed firm name county well located

LANDOWNER: <u>Dennis Hawken</u> <u>Rt. 2</u>	description of formations encountered	from	to
<u>Calderwood, Mo.</u> (mailing address)	<u>Red Clay</u>	<u>0</u>	<u>10</u>
WELL LOCATION: sec. <u>35</u> T <u>4</u> N R. <u>6</u> E ⑤ ④ _____ miles _____ of <u>Independence</u> (distance) (direction) (nearest town)	<u>Red Sand + clay</u>	<u>10</u>	<u>100</u>
WELL PURPOSE: <u>Home</u> (home, irrigation, municipal, industrial)	<u>white sand</u>	<u>100</u>	<u>140</u>
WELL COMPLETION DATA: (1) diameter (inches) <u>4</u> (2) total depth (feet) <u>140</u> (3) static water level (feet) <u>60</u> below above top of ground. (4) casing <u>PVC</u> , <u>140</u> , (material) (depth) _____ If telescope see back. (size) (5) screen <u>7</u> , <u>133</u> (length) (depth to top) <u>4"</u> , <u>gravel type</u> (size) (material) (6) pump <u>1/2</u> , <u>10</u> (HP) (yield gpm) <u>220V</u> (type power) (7) electric log <u>No</u> (yes or no) _____ (organization running log) (8) how well bottom plugged <u>Cap</u>			
DRILLERS REMARKS:			

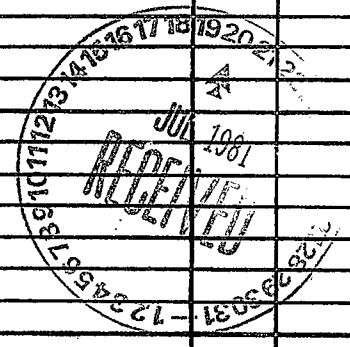

If well telescopes please sketch and show depths.

GROUND LEVEL

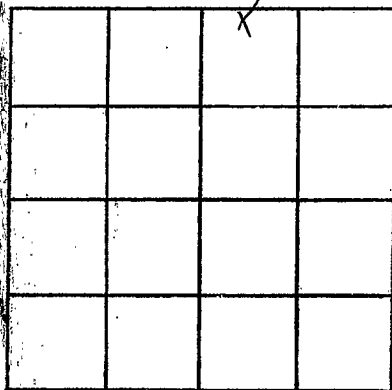

SECTION 35

Please indicate well location X.

ADDITIONAL INFORMATION

If more than one screen,
show locations of each on sketch.