

MISSISSIPPI DEPARTMENT OF NATURAL RESOURCES
Bureau of Land and Water Resources
 Southport Mall
 P.O. Box 10631
 Jackson, Mississippi 39209
WATER WELL DRILLERS LOG

Date _____

4-7 1982 date well completed HICKS WELL COMPANY firm name Tate county well located
 RT. 1 - BOX 157

LANDOWNER: Jerry B. WATKINS
Box 4 Poaquille Corn
Caldwell Miss. 38618
 (mailing address)

description of formations encountered	from	to
Red Clay	0	15
Red Sand & Gravel	15	35
Brown sand	35	125
White Sand	125	142

WELL LOCATION:
 sec. 31 T. 4 S. R. 6 E. W.
1 miles NW of Poaquille
 (distance) (direction) (nearest town)

WELL PURPOSE: Home
 (home, irrigation, municipal, industrial)

- WELL COMPLETION DATA:
- (1) diameter (inches) 4
 - (2) total depth (feet) 142
 - (3) static water level (feet) 100 below above top of ground.
 - (4) casing PVC 142
 (material) (depth)
 - If telescope see back.
 (size)
 - (5) screen 13 139
 (length) (depth to top)
 - 02 PVC
 (size) (material)
 - (6) pump 1/2 10
 (HP) (yield gpm)
 - 220V
 (type power)
 - (7) electric log No
 (yes or no)
 - (organization running log)
 - (8) how well bottom plugged Cap

DRILLERS REMARKS: _____


DEPT. OF NATURAL RESOURCES
 BUREAU OF LAND & WATER RESOURCES

APR 15 1982

RECEIVED

If well telescopes please sketch and show depths.

GROUND LEVEL

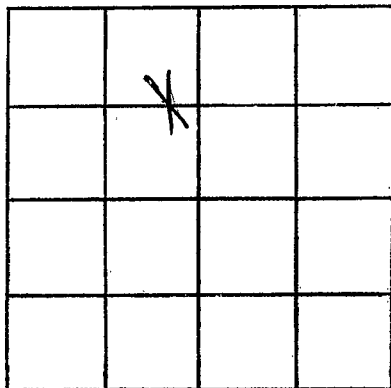

SECTION 31

Please indicate well location X.

ADDITIONAL INFORMATION

If more than one screen,
show locations of each on sketch.