

MISSISSIPPI DEPARTMENT OF NATURAL RESOURCES

Bureau of Land and Water Resources

Southport Mall

P.O. Box 10631

Jackson, Mississippi 39209

WATER WELL DRILLERS LOG

Date  
 7-15  
 1982

HICKS WELL CO.

Rt. 1, Box 157

Senatobia, MS 38668

Tate

date well completed

county well located

LANDOWNER:	description of formations encountered	from	to
(mailing address)			
Herbert Green Greenleaf Comm. Caldwell, Miss.	Red clay	0	25
	Gravel	25	55
	White clay	55	85
	White sand	85	155
<p>WELL LOCATION:</p> <p>sec. <u>4</u> T <u>4</u> N R <u>6</u> E <u>SE</u></p> <p><u>1 1/2</u> miles <u>NE</u> of <u>Senatobia</u></p> <p>(distance) (direction) (nearest town)</p>			
<p>WELL PURPOSE: <u>Home</u></p> <p>(home, irrigation, municipal, industrial)</p>			
<p>WELL COMPLETION DATA:</p> <p>(1) diameter (inches) <u>4</u></p> <p>(2) total depth (feet) <u>155</u></p> <p>(3) static water level (feet) <u>120</u> <u>below</u> above top of ground.</p> <p>(4) casing <u>PVC</u>, <u>155</u>, (material) (depth) <u>4"</u> If telescope see back. (size)</p> <p>(5) screen <u>2'</u>, <u>148'</u> (length) (depth to top) <u>32</u>, <u>PVC &amp; Gravel</u> (size) (material)</p> <p>(6) pump <u>1/2</u>, <u>10</u> (HP) (yield gpm) <u>220V</u> (type power)</p> <p>(7) electric log <u>No</u> (yes or no)</p> <p>(8) how well bottom plugged <u>CAP</u></p>			
<p>DRILLERS REMARKS:</p>			


DEPT. OF NATURAL RESOURCES  
 BUREAU OF LAND & WATER RESOURCES

AUG - 4 1982

RECEIVED

If well telescopes please sketch and show depths.

GROUND LEVEL

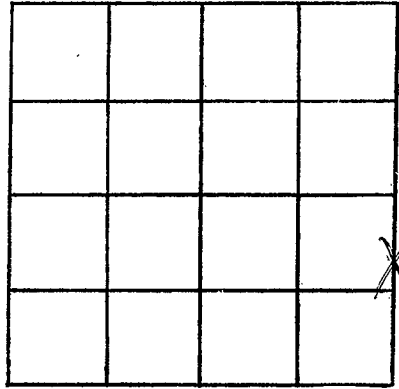

SECTION 4

Please indicate well location X.

ADDITIONAL INFORMATION

If more than one screen,  
show locations of each on sketch.