

MISSISSIPPI DEPARTMENT OF NATURAL RESOURCES

Bureau of Land and Water Resources

Southport Mall

P.O. Box 10631

Jackson, Mississippi 39209

WATER WELL DRILLERS LOG

Date  
C 2078

1-13 1983  
date well completed

HICKS WELL CO.  
Dr. 1 Box 157  
Senatobia, MS 38650

Tate  
county well located

LANDOWNER: Robert Massey  
Sen. Del.  
Independence, Miss.  
(mailing address) 38638

description of formations encountered

from

to

<u>Red Clay</u>	<u>0</u>	<u>10</u>
<u>White sand</u>	<u>10</u>	<u>145</u>

WELL LOCATION:

sec. 12 T 4 N R 6 E  
1 miles NW of Wakefield  
(distance) (direction) (nearest town)

WELL PURPOSE: Home town  
(home, irrigation, municipal, industrial)

WELL COMPLETION DATA:

- (1) diameter (inches) 4
- (2) total depth (feet) 145
- (3) static water level (feet) 100 below above top of ground.
- (4) casing PVC 145  
(material) (depth)  
4"  
(size) if telescope see back.
- (5) screen 10' 135'  
(length) (depth to top)  
013 PVC  
(size) (material)
- (6) pump 1 18  
(HP) (yield gpm)  
220V  
(type power)
- (7) electric log no  
(yes or no)

(organization running log)

(8) how well bottom plugged Cup

DRILLERS REMARKS:


DEPT. OF NATURAL RESOURCES  
BUREAU OF LAND & WATER RESOURCES

FEB 22 1983

RECEIVED

If well telescopes please sketch and show depths.

GROUND LEVEL

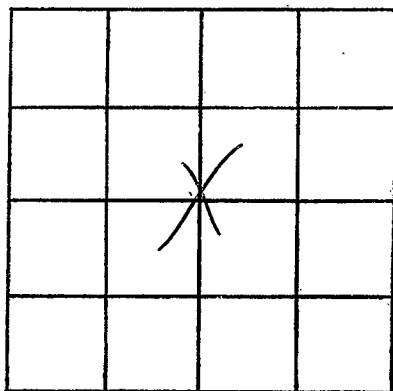

SECTION 12

Please indicate well location X.

ADDITIONAL INFORMATION

If more than one screen,  
show locations of each on sketch.