

MISSISSIPPI DEPARTMENT OF NATURAL RESOURCES

Bureau of Land and Water Resources

Southport Mall

P.O. Box 10631

Jackson, Mississippi 39209

WATER WELL DRILLERS LOG

<i>Date</i>
<i>C200A</i>

4-25  
date well completed

1983 Gullett Well Drilling  
firm name

Tate  
county well located

LANDOWNER: *Roy Golden*  
*Rt. 3 Box 81*  
*Coldwater, Ms. 38618*  
(mailing address)

description of formations encountered	from	to
<i>Top Soil</i>	<i>0</i>	<i>10</i>
<i>Sand gravel</i>	<i>10</i>	<i>30</i>
<i>Thick clay and sand</i>	<i>30</i>	<i>90</i>

WELL LOCATION:  
sec. *6* T. *4* N. R. *6* E.  
*7* miles *North east* of *Coldwater*  
(distance) (direction) (nearest town)

WELL PURPOSE: *Home*  
(home, irrigation, municipal, industrial)

- WELL COMPLETION DATA:
- (1) diameter (inches) *4"*
  - (2) total depth (feet) *100'*
  - (3) static water level (feet) *80'* below above top of ground.
  - (4) casing *160 PVC, 100'*  
(material) (depth)  
*4"* if telescope see back.  
(size)
  - (5) screen *10, 90'*  
(length) (depth to top)  
*4"*, *160 PVC*  
(size) (material)
  - (6) pump *1/2, 10*  
(HP) (yield gpm)  
*electric*  
(type power)
  - (7) electric log (yes or no)  
  
(organization running log)
  - (8) how well bottom plugged *Cap*

DRILLERS REMARKS:


DEPT. OF NATURAL RESOURCES  
BUREAU OF LAND & WATER RESOURCES

JUN 21 1983

RECEIVED

If well telescopes please sketch and show depths.

GROUND LEVEL

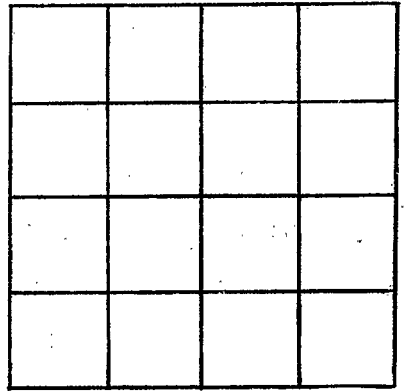

SECTION \_\_\_\_\_

Please indicate well location X.

ADDITIONAL INFORMATION

If more than one screen,  
show locations of each on sketch.