

MISSISSIPPI DEPARTMENT OF NATURAL RESOURCES

Bureau of Land and Water Resources

Southport Mall

P.O. Box 10631

Jackson, Mississippi 39209

WATER WELL DRILLERS LOG

Date  
8-26-83  
C 2080

8-26-83 date well completed  
Gullett Well Drilling firm name  
Tate county well located

LANDOWNER: Charles C. Darnell, Jr.  
Pt. 3 Box 342  
Senatobia, Ms 38668  
(mailing address)

description of formations encountered	depth	
	from	to
Clay	0	25'
Sand and shell sand	25	130

WELL LOCATION:  
sec. 13 T. 4 N R. 6 E  
S W  
3 miles W of Washfield  
(distance) (direction) (nearest town)

WELL PURPOSE: home  
(home, irrigation, municipal, industrial)

WELL COMPLETION DATA:

(1) diameter (inches) 4"

(2) total depth (feet) 130'

(3) static water level (feet) 30' below top of ground.

(4) casing 1160 PVC, 120' (material) (depth)  
(size) if telescope see back.

(5) screen 10' 120' (length) (depth to top)  
4" 1160 PVC (size) (material)

(6) pump 1/2 10 (HP) (yield gpm)  
elec. (type power)

(7) electric log NO (yes or no)  
(organization running log)

(8) how well bottom plugged Cap

DRILLERS REMARKS:


DEPT. OF NATURAL RESOURCES  
BUREAU OF LAND & WATER RESOURCES

AUG 31 1983

RECEIVED

If well telescopes please  
sketch and show depths.

GROUND LEVEL

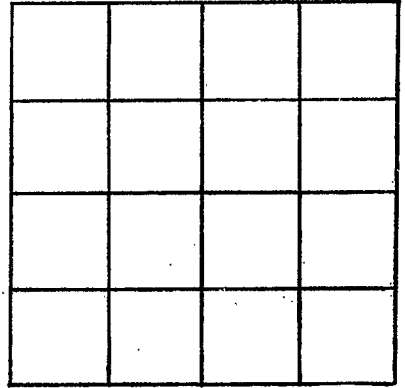

SECTION \_\_\_\_\_

Please indicate well location X.

ADDITIONAL INFORMATION

If more than one screen,  
show locations of each on sketch.