

MISSISSIPPI DEPARTMENT OF NATURAL RESOURCES

Bureau of Land and Water Resources

Southport Mall

P.O. Box 10631

Jackson, Mississippi 39209

WATER WELL DRILLERS LOG

Date
 C 2081

HICKS WELL CO.
 firm name, Box 157
 Senatobia, MS 38668

1/5 19 84
 date well completed

Tate
 county well located

LANDOWNER: Wendell Roberts
R# 3
Calderwater, Ms. 38618
 (mailing address)

description of formations encountered	from	to
Red Clay	0	20
Red Sand	20	40
white Sand & clay	40	100
white sand	100	140

WELL LOCATION:
 sec. 12 T. 4 N. R. 6 E.
1/2 miles N of Wakfield
 (distance) (direction) (nearest town)

WELL PURPOSE: Home
 (home, irrigation, municipal, industrial)

WELL COMPLETION DATA:

(1) diameter (inches) 4

(2) total depth (feet) 140

(3) static water level (feet) 70 ^{below}/_{above} top of ground

(4) casing PVC, 140
 (material), (depth)
4"
 (size) if telescope see back.

(5) screen 10', 130
 (length), (depth to top)
.010, PVC
 (size), (material)

(6) pump 1/2, 10
 (HP), (yield gpm)
220V
 (type power)

(7) electric log No
 (yes or no)
No
 (organization running log)

(8) how well bottom plugged Cap


DRILLERS REMARKS:

DEPT. OF NATURAL RESOURCES
 BUREAU OF LAND & WATER RESOURCES

JAN 30 1984
 RECEIVED

If well telescopes please sketch and show depths.

GROUND LEVEL

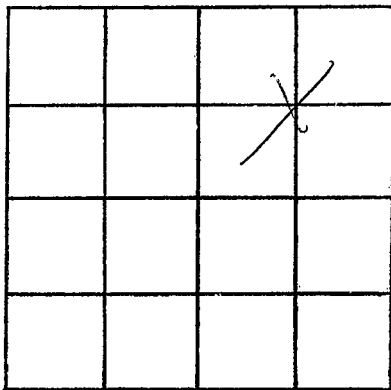

SECTION

12

Please indicate well location X.

ADDITIONAL INFORMATION

If more than one screen,
show locations of each on sketch.