

MISSISSIPPI DEPARTMENT OF NATURAL RESOURCES

Bureau of Land and Water Resources

Southport Mall

P.O. Box 10631

Jackson, Mississippi 39209

WATER WELL DRILLERS LOG

Date
 5/17/84

HICKS WELL CO.
 Rt. 1, Box 157
 Senatobia, MS 38668

Date
 county well located

date well completed

county well located

LANDOWNER: Bill Buford
Gen. Del.

description of formations encountered

from

to

Independence, Ms. 38638
 (mailing address)

Red Clay

0

13

Red sand

15

50

WELL LOCATION:

sec. 27 T 4 N R 6 E
0 miles (distance) of Independence (direction) (nearest town)

white sand

50

140

WELL PURPOSE: Home
 (home, irrigation, municipal, industrial)

WELL COMPLETION DATA:

(1) diameter (inches) 4
 (2) total depth (feet) 140

(3) static water level (feet) 60 ^{below} above top of ground.

(4) casing PVC, 140
 (material) (depth)

4" if telescope see back.
 (size)

(5) screen 10', 130
 (length) (depth to top)

0 1/2", PVC
 (size) (material)

(6) pump 1/2, 10
 (HP) (yield gpm)

220V
 (type power)

(7) electric log No
 (yes or no)

(organization running log)

(8) how well bottom plugged Cap

DRILLERS REMARKS:


DEPT. OF NATURAL RESOURCES
 BUREAU OF LAND & WATER RESOURCES

MAY 23 1984

RECEIVED

If well telescopes please sketch and show depths.

GROUND LEVEL

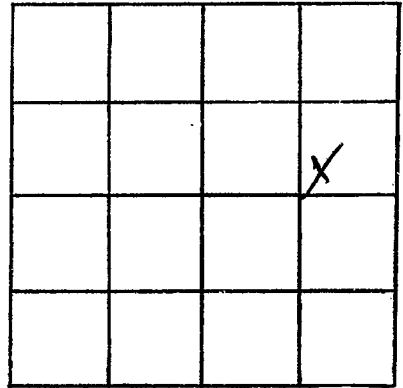

SECTION 27

Please indicate well location X.

ADDITIONAL INFORMATION

If more than one screen,
show locations of each on sketch.