

MISSISSIPPI DEPARTMENT OF NATURAL RESOURCES

Bureau of Land and Water Resources

Southport Mall

P.O. Box 10631

Jackson, Mississippi 39209

WATER WELL DRILLERS LOG

HICKS WELL CO.

Rt. 1, Box 157

Sendtob, MS 38668

Tate

TATE  
C 2083

6/1 1984  
date well completed

county well located

LANDOWNER: Independence Ball Field

description of formations encountered

from to

Gen. Del.

Independence, Ms. 38638  
(mailing address)

Red Clay

0 10

Red Sand

10 30

WELL LOCATION:

sec. 27 T. 4 N. R. 6 E.  
miles of Independence  
(distance) (direction) (nearest town)

white sand

30 115

WELL PURPOSE: Ball Club  
(home, irrigation, municipal, industrial)

WELL COMPLETION DATA:

(1) diameter (inches) 4

(2) total depth (feet) 115

(3) static water level (feet) 80 below above top of ground.

(4) casing PVC, 115  
(material) (depth)

4"  
(size) if telescope see back.

(5) screen 10', 105'  
(length) (depth to top)

1010, PVC  
(size) (material)

(6) pump 1/2, 10  
(HP) (yield gpm)

ZZW  
(type power)

(7) electric log No  
(yes or no)

(organization running log)

(8) how well bottom plugged Cap


DRILLERS REMARKS:

DEPT. OF NATURAL RESOURCES  
BUREAU OF LAND & WATER RESOURCES

JUL 10 1984  
RECEIVED

If well telescopes please sketch and show depths.

GROUND LEVEL

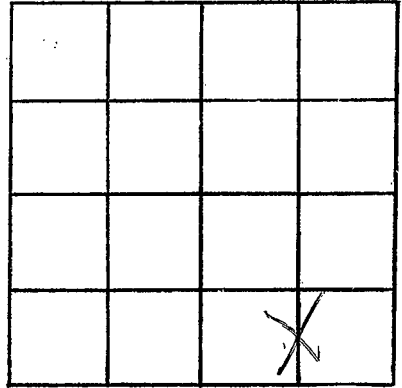

SECTION 27

Please indicate well location X.

ADDITIONAL INFORMATION

If more than one screen,  
show locations of each on sketch.