

MISSISSIPPI DEPARTMENT OF NATURAL RESOURCES

Bureau of Land and Water Resources

Southport Mall

P.O. Box 10631

Jackson, Mississippi 39209

WATER WELL DRILLERS LOG

NICKS WELL CO.

firm name Box 157  
SA 38668

county well located

TATE

C 2084

6/25/84  
date well completed

84

~~Tate~~

LANDOWNER: James Paxon  
Rt. 3

description of formations encountered

from

to

Caldwater, Ms. 38618  
(mailing address)

Red Clay

0 20

Red Sand

20 60

WELL LOCATION:

sec. 8 T 4 N R 6 E  
1 miles SW of Acened  
(distance) (direction) (nearest town)

white sand

60 145

WELL PURPOSE: home  
(home, irrigation, municipal, industrial)

WELL COMPLETION DATA:

- (1) diameter (inches) 4
- (2) total depth (feet) 145
- (3) static water level (feet) 80 below top of ground.
- (4) casing PVC, 145 (material), (depth)  
4" (size) If telescope see back.
- (5) screen 10' length, 135' (depth to top)  
2 1/2" (size), PVC (material)
- (6) pump 1/2 (HP), 10 (yield gpm)  
220V (type power)
- (7) electric log No (yes or no)  
(organization running log)
- (8) how well bottom plugged Cap


DRILLERS REMARKS:

DEPT. OF NATURAL RESOURCES  
BUREAU OF LAND & WATER RESOURCES

JUL 10 1984  
RECEIVED

If well telescopes please sketch and show depths.

GROUND LEVEL

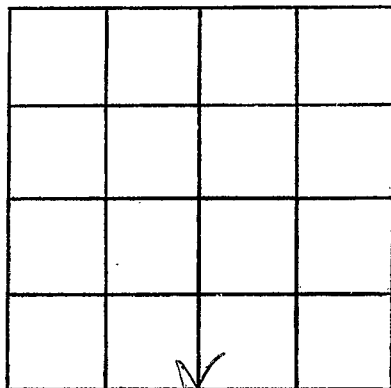

SECTION 8

Please indicate well location X.

ADDITIONAL INFORMATION

If more than one screen,  
show locations of each on sketch.