

MISSISSIPPI DEPARTMENT OF NATURAL RESOURCES

Bureau of Land and Water Resources

Southport Mall

P.O. Box 10631

Jackson, Mississippi 39209

WATER WELL DRILLERS LOG

HICKS WELL COMPANY

C2085
Tate
5-27-85

5-27, 1985      RT 1 - BOX 157      Tate  
 date well completed      firm name      county well located  
 SENATOBIA, MISS.      Tate

LANDOWNER: Willie Edwards Sr	description of formations encountered	from	to
RT #3 Box 373	Red Clay	0	10
Coldwater MS 38618 (mailing address)	Gravel	10	30
WELL LOCATION: sec. 29 T 4 N R 6 E 3 miles NW of Independence (distance) (direction) (nearest town)	White Sand	30	125
WELL PURPOSE: Home (home, irrigation, municipal, industrial)			
WELL COMPLETION DATA:			
(1) diameter (inches) 4"			
(2) total depth (feet) 125'			
(3) static water level (feet) 60 below top of ground.			
(4) casing PVC, 115' (material) (depth) 4" if telescope see back. (size)			
(5) screen 10', 115' (length) (depth to top) 10 1/2", PVC (size) (material)			
(6) pump 1/2, 10 (HP) (yield gpm) 220 V (type power)			
(7) electric log NO (yes or no) (organization running log)			
(8) how well bottom plugged Cap			


RECEIVED  
 SEP 28 1985

DRILLERS REMARKS:

Department of Natural Resources  
 Bureau of Land & Water Resources

If well telescopes please sketch and show depths.

GROUND LEVEL

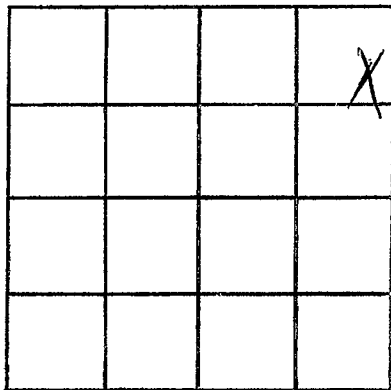

SECTION 29

Please indicate well location X.

ADDITIONAL INFORMATION

If more than one screen,  
show locations of each on sketch.