

MISSISSIPPI DEPARTMENT OF NATURAL RESOURCES

Bureau of Land and Water Resources

Southport Mall

P.O. Box 10631

Jackson, Mississippi 39209

WATER WELL DRILLERS LOG

TATE
C2086

8-13 1985
date well completed

HICKS WELL COMPANY
RT. 1 - BOX 167

State
county well located

LANDOWNER: Billy Neal

SENATOGA, MISS.
description of formations encountered

Rt # 2

Caldwell, MS 38618
(mailing address)

Red clay 0 10

Red sand 10 30

White sand 30 155

WELL LOCATION:

sec. 31 T 4 N R 6 E
S W
4 miles West of Independence
(distance) (direction) (nearest town)

WELL PURPOSE: Home
(home, irrigation, municipal, industrial)

WELL COMPLETION DATA:

(1) diameter (inches) 4"
(2) total depth (feet) 155'
(3) static water level (feet) 120 ^{below} above top of ground.

(4) casing PVC, 145'
(material) (depth)
4" if telescope see back.
(size)

(5) screen 10', 145'
(length) (depth to top)
.013, PVC
(size) (material)


(6) pump 1/2, 10
(HP) (yield gpm)
220 ✓
(type power)

(7) electric log NO
(yes or no)

(organization running log)

(8) how well bottom plugged Cap


DRILLERS REMARKS:

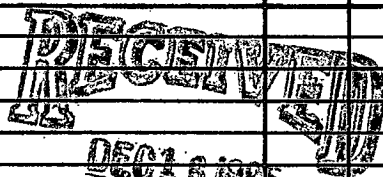

Department of Natural Resources
Bureau of Land and Water Resources

If well telescopes please sketch and show depths.

GROUND LEVEL

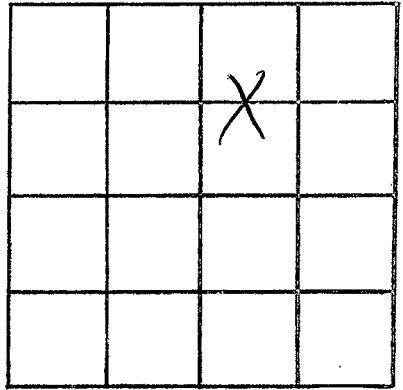

SECTION 31

Please indicate well location X.

ADDITIONAL INFORMATION

If more than one screen,
show locations of each on sketch.