

MISSISSIPPI DEPARTMENT OF NATURAL RESOURCES

Bureau of Land and Water Resources

Southport Mall

P.O. Box 10631

Jackson, Mississippi 39209

WATER WELL DRILLERS LOG

| |
|--------|
| DATE |
| C 2087 |
| |
| |

HICKS WELL COMPANY

10-24 1985
date well completed

RT. 1 BOX 157
firm name
SENATORIA, MISS.

date
county well located

LANDOWNER: Bernal Pratt

Rt # 3 Box 446

Caldwater, MS 38818
(mailing address)

description of formations encountered

from

to

Red clay

0

10

Red sand & gravel

10

30

WELL LOCATION:

sec. 16 T 4 N R 6 E
S W
5 miles NW of Independence
(distance) (direction) (nearest town)

White sand & white clay

30

80

White sand

80

125

WELL PURPOSE: Home
(home, irrigation, municipal, industrial)

WELL COMPLETION DATA:

- (1) diameter (inches) 4"
- (2) total depth (feet) 125'
- (3) static water level (feet) 80' below above top of ground.
- (4) casing PVC, 125'
(material) (depth)
4"
(size) if telescope see back.
- (5) screen 10', 115'
(length) (depth to top)
.013, PVC
(size) (material)
- (6) pump 1/2, 10
(HP) (yield gpm)
220V
(type power)
- (7) electric log NO
(yes or no)

(organization running log)

(8) how well bottom plugged Cap


DRILLERS REMARKS:

RECEIVED
DEC 16 1985

Department of Natural Resources
Bureau of Land and Water Resources

If well telescopes please sketch and show depths.

GROUND LEVEL

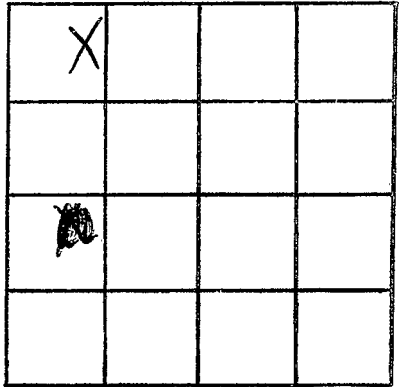

SECTION 16

Please indicate well location X.

ADDITIONAL INFORMATION

If more than one screen, show locations of each on sketch.