

MISSISSIPPI DEPARTMENT OF NATURAL RESOURCES

Bureau of Land and Water Resources

Southport Mall

P.O. Box 10631

Jackson, Mississippi 39209

WATER WELL DRILLERS LOG

Tape
C2088

HICKS WELL COMPANY

Date

12-8-85
date well completed

Rt. 1 - Box 68

county well located

SENATOGA, MISS.

LANDOWNER: Dale Doney
Rt # 2 Box 68
Caldwater MS 38618
(mailing address)

description of formations encountered	from	to
Red clay	0	10
Red sand	10	50
White sand & clay	50	100
White sand	100	155


WELL LOCATION:
sec 30 T 4 N R 6 E
S W
4 miles W of Independence
(distance) (direction) (nearest town)

WELL PURPOSE: Home
(home, irrigation, municipal, industrial)

WELL COMPLETION DATA:

- (1) diameter (inches) 4"
- (2) total depth (feet) 155'
- (3) static water level (feet) 100' below top of ground.
- (4) casing PVC, 145' (depth)
4" (size) if telescope see back.
- (5) screen 10' (length), 145' (depth to top)
.013 (size), PVC (material)
- (6) pump 1/2 (HP), 10 (yield gpm)
220 W (type power)
- (7) electric log NO (yes or no)
(organization running log)
- (8) how well bottom plugged Cop


DRILLERS REMARKS:

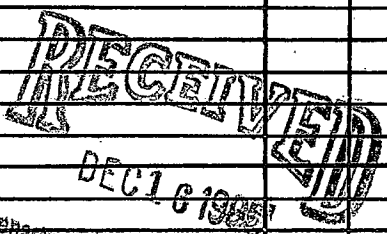

Department of Natural Resources
Bureau of Land & Water

If well telescopes please sketch and show depths.

GROUND LEVEL

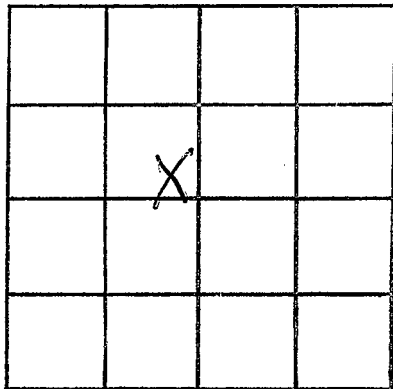

SECTION 30

Please indicate well location X.

ADDITIONAL INFORMATION

If more than one screen,
show locations of each on sketch.