

MISSISSIPPI DEPARTMENT OF NATURAL RESOURCES

Bureau of Land and Water Resources

Southport Mall

P.O. Box 10631

Jackson, Mississippi 39209

WATER WELL DRILLERS LOG

TATE
COB89

4-1 1986 Gullett Water Well Tate  
 date well completed                      firm name                      county well located


LANDOWNER: Bailey, Keith  
 Coldwater, Ms  
 (mailing address)

description of formations encountered	from	to
Top Soil	0	2
Clay	2	20
Red Sand & gravel	20	60
Clay	60	70
White Sand	70	150

WELL LOCATION:  
 sec 3 T 4 N R 6 E  
 5 miles NW of Independence  
 (distance) (direction) (nearest town)

WELL PURPOSE: Home  
 (home, irrigation, municipal, industrial)

WELL COMPLETION DATA:  
 (1) diameter (inches) 4"  
 (2) total depth (feet) 150'  
 (3) static water level (feet) 110' below top of ground.  
 (4) casing PVC 140'  
     (material) (depth)  
     4" if telescope see back.  
     (size)  
 (5) screen 10' 140'  
     (length) (depth to top)  
     4" PVC  
     (size) (material)  
 (6) pump 1/2 10  
     (HP) (yield gpm)  
     Elec  
     (type power)  
 (7) electric log No  
     (yes or no)  
     (organization running log)  
 (8) how well bottom plugged Cap

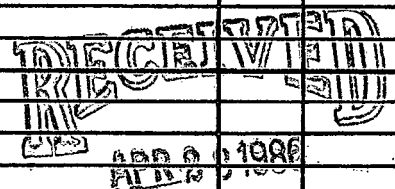


Department of Natural Resources  
 Bureau of Land and Water Resources

DRILLERS REMARKS:

If well telescopes please sketch and show depths.

GROUND LEVEL

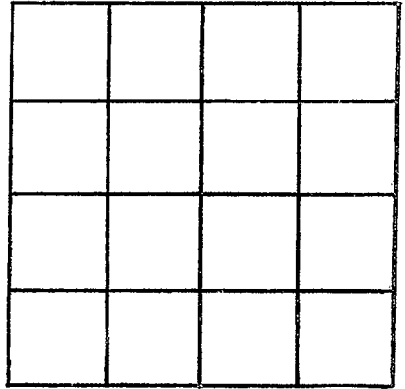

SECTION \_\_\_\_\_

Please indicate well location X.

ADDITIONAL INFORMATION

If more than one screen,  
show locations of each on sketch.