

MISSISSIPPI DEPARTMENT OF NATURAL RESOURCES

Bureau of Land and Water Resources

Southport Mall

P.O. Box 10631

Jackson, Mississippi 39209

WATER WELL DRILLERS LOG

TATE
C-2090

4-16 1986 *Summit Water Well* *Inte*
date well completed firm name county well located

LANDOWNER:
Billy C. Frederick
4150 Box 321
Batesville, Mo. 38606
(mailing address)

WELL LOCATION:
sec 35 T 4 N R 6 E
4 miles SE of Exedepmcb
(distance) (direction) (nearest town)

WELL PURPOSE: name
(home, irrigation, municipal, industrial)

- WELL COMPLETION DATA:
- (1) diameter (inches) 4"
 - (2) total depth (feet) 175'
 - (3) static water level (feet) 80' below above top of ground.
 - (4) casing PVC, 16.5'
(material) (depth)
4" if telescope see back.
(size)
 - (5) screen 10", 16.5'
(length) (depth to top)
4", PVC
(size) (material)
 - (6) pump 1/2, 10
(HP) (yield gpm)
Elec
(type power)
 - (7) electric log No
(yes or no)
Cap
(organization running log)
 - (8) how well bottom plugged Cap

description of formations encountered	from	to
<i>Imp soil</i>	<i>0</i>	<i>2</i>
<i>Clay Red</i>	<i>2</i>	<i>25</i>
<i>Red Sand & Clay</i>	<i>25</i>	<i>50</i>
<i>White Sand</i>	<i>50</i>	<i>100</i>
<i>Blue Clay</i>	<i>100</i>	<i>130</i>
<i>White Sand</i>	<i>130</i>	<i>175</i>


TRIPLE CELL WELL
APR 28 1986

DRILLERS REMARKS:

Department of Natural Resources
Bureau of Land and Water Resources

If well telescopes please sketch and show depths.

GROUND LEVEL

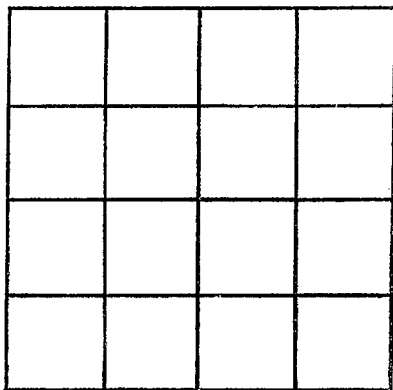

SECTION _____

Please indicate well location X.

ADDITIONAL INFORMATION

If more than one screen, show locations of each on sketch.