

MISSISSIPPI DEPARTMENT OF NATURAL RESOURCES

Bureau of Land and Water Resources

Southport Mall

P.O. Box 10631

Jackson, Mississippi 39209

WATER WELL DRILLERS LOG

BOB SMITH WELL SERVICE

570 SOUTH ST.

HERNANDO, MS 38632

TATE
C 2002

4/20 19 86
date well completed


Jate

county well located

LANDOWNER: <u>Michael Dancy</u>	description of formations encountered	from	to
<u>Scotland rd</u> <u>Coldwater</u> (mailing address)	<u>Top soil</u>	<u>0</u>	<u>5</u>
	<u>red clay</u>	<u>5</u>	<u>20</u>
	<u>red sand</u>	<u>20</u>	<u>60</u>
	<u>blue clay</u>	<u>60</u>	<u>120</u>
	<u>sand</u>	<u>120</u>	<u>160</u>
WELL LOCATION: sec. <u>30</u> T <u>4</u> N R <u>6</u> E <u>5</u> miles <u>E</u> of <u>Coldwater</u> (distance) (direction) (nearest town)			
WELL PURPOSE: <u>Home, Irrigation, municipal, industrial</u>			
WELL COMPLETION DATA:			
(1) diameter (inches) <u>4</u>			
(2) total depth (feet) <u>160</u>			
(3) static water level (feet) <u>120</u> below above top of ground.			
(4) casing <u>Plastic</u> <u>160</u> (material) (depth)			
_____ (size) if telescope see back.			
(5) screen <u>20</u> <u>140</u> (length) (depth to top)			
_____ (size) <u>Plastic</u> (material)			
(6) pump <u>4</u> <u>15</u> (HP) (yield gpm)			
_____ (type power)			
(7) electric log _____ (yes or no)			
_____ (organization running log)			
(8) how well bottom plugged <u>Cap</u>			
DRILLERS REMARKS:			

If well telescopes please sketch and show depths.

GROUND LEVEL

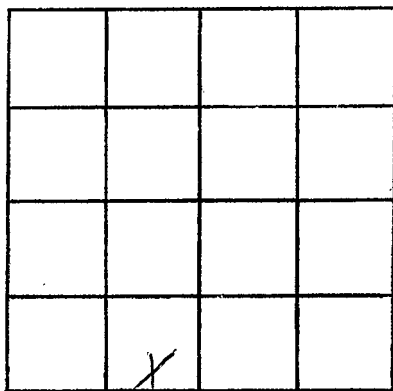

SECTION _____

Please indicate well location X.

ADDITIONAL INFORMATION

If more than one screen,
show locations of each on sketch.