

MISSISSIPPI DEPARTMENT OF NATURAL RESOURCES

Bureau of Land and Water Resources

COUNTY WELL LOCATED <i>Itala</i>	
WELL NUMBER <i>C</i>	CODED
DATE WELL COMPLETED <i>8-25-87</i>	

PERMIT NUMBER
NAME OF DRILLER'S FIRM HICKS WELL COMPANY
ADDRESS <i>RT. 1 BOX 157 SENATOBIA, MISS.</i>

P.O. Box 10631
Jackson, Mississippi 39209
WATER WELL DRILLERS LOG

NAME & MAILING ADDRESS OF LANDOWNER <i>Mike Bosty Bosty Highway Independence, MS</i>			
WELL LOCATION	SEC <i>26</i>	TOWNSHIP <i>4</i>	RANGE <i>N 6 E</i>
DISTANCE <i>1</i> Miles	DIRECTION <i>E</i>	NEAREST TOWN <i>Independence</i>	
OTHER LANDMARK			
WELL PURPOSE <input checked="" type="checkbox"/> Home, <input type="checkbox"/> Irrigation, <input type="checkbox"/> Municipal, <input type="checkbox"/> Industrial, <input type="checkbox"/> Fish Pond, etc.			

PUMP DATA		
PUMP TYPE (Circle One): <input checked="" type="checkbox"/> Submersible, <input type="checkbox"/> Turbine, <input type="checkbox"/> Jet, <input type="checkbox"/> Flowing Well, <input type="checkbox"/> Other (Describe) _____		
POWER TYPE (Circle One): <input checked="" type="checkbox"/> Electric, <input type="checkbox"/> Tractor, <input type="checkbox"/> Diesel, <input type="checkbox"/> Gasoline, <input type="checkbox"/> Butane, <input type="checkbox"/> Other (Describe) _____		
Pump Capacity (GPM) <i>10</i>	No. of Stages <i>7</i>	Setting Depth <i>80</i> FT.
PUMP TEST		
Well yielded _____ GPM with a drawdown of _____ ft. after _____ hours of pumping		

WELL DATA				
Well Depth <i>140'</i>	Casing Diameter (In.) <i>4"</i>	Casing Length (Ft.) <i>130'</i>		
Type of Casing <i>Pvc</i>	Hole Depth <i>140'</i>	Depth to Static Water Level <i>60'</i>		
TYPE OF COMPLETION: (Circle One or More): <input type="checkbox"/> Gravel Packed, <input type="checkbox"/> Underreamed, <input type="checkbox"/> Telescoped, <input type="checkbox"/> Natural Development, <input type="checkbox"/> Open Hole, <input type="checkbox"/> Other (Describe) <i>Pvc Casing</i>				
Top of Lap Pipe or Reduction in Casing				
<table style="width: 100%; border: none;"> <tr> <td style="width: 20%; border: none;">FEET</td> <td style="border: none;">IF TELESCOPED OR MORE THAN ONE SCREEN: USE BACK PAGE</td> </tr> </table>			FEET	IF TELESCOPED OR MORE THAN ONE SCREEN: USE BACK PAGE
FEET	IF TELESCOPED OR MORE THAN ONE SCREEN: USE BACK PAGE			

LOG DATA	
TYPE OF LOG RUN (Circle One): <input type="checkbox"/> No Log Run, <input type="checkbox"/> Electric, <input type="checkbox"/> Gamma Ray, <input type="checkbox"/> Density, <input type="checkbox"/> Sonic, <input type="checkbox"/> Neutron, <input type="checkbox"/> Other (Describe) _____	
Name of Organization Running Log	


SCREEN DATA		
Diameter - Inches <i>4"</i>	Length - Feet <i>10'</i>	Slot Size - Inches <i>-013</i>
Screen Type <i>Pvc</i>		Depth to Bottom - Feet <i>140'</i>

GEOLOGIC DATA (Office Use Only)			
Surface Elev.	Geologic Unit	Unit Thickness	Depth to Top
Subs. SWL	Date	Analysis	Aquifer Test
Driller's Remarks			

DESCRIPTION OF FORMATIONS ENCOUNTERED	FROM	TO	FORMATIONS (continued)	FROM	TO
<i>Red Clay</i>	<i>0</i>	<i>15</i>	<div style="border: 2px solid black; padding: 5px; display: inline-block;"> PROJECT SEP 16 1987 Department of Natural Resources Bureau of Land & Water Resources </div>		
<i>Shovel Head Sand</i>	<i>25</i>	<i>40</i>			
<i>White claystone sand</i>	<i>40</i>	<i>80</i>			
<i>White sand</i>	<i>80</i>	<i>140</i>			
IF MORE SPACE IS NEEDED, USE BACK					

If well telescopes please sketch and show depths.

GROUND LEVEL

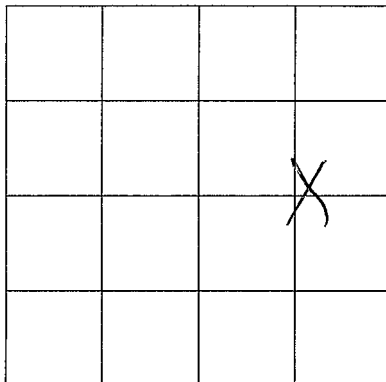

SECTION 26

Please indicate well location X.

ADDITIONAL INFORMATION

If more than one screen,
show location of each on sketch.