

MISSISSIPPI DEPARTMENT OF NATURAL RESOURCES
Bureau of Land and Water Resources

P.O. Box 10631
Jackson, Mississippi 39209
WATER WELL DRILLERS LOG

COUNTY WELL LOCATED <i>Tate</i>	
WELL NUMBER <i>2103</i>	CODED
DATE WELL COMPLETED <i>9-20-88</i>	

PERMIT NUMBER
NAME OF DRILLING FIRM <i>WELL COMPANY</i>
ADDRESS <i>RT. 1 - BOX 157</i>
<i>SENATORIA</i>

NAME & MAILING ADDRESS OF LANDOWNER <i>James Carpenter</i>			
<i>Rt. 3, Wakefield</i>			
<i>Coldwater, Ms. 38618</i>			
WELL LOCATION:	SEC	TOWNSHIP	RANGE
	<i>13</i>	<i>4</i>	<i>N 6 E</i>
DISTANCE	DIRECTION	NEAREST TOWN	
<i>1/2</i> Miles	<i>W</i>	of <i>Wakefield</i>	
OTHER LANDMARK			
WELL PURPOSE: <i>Home, Irrigation, Municipal, Industrial, Fish Pond, etc.</i>			

PUMP DATA		
PUMP TYPE (Circle One): <input checked="" type="radio"/> Submersible, Turbine, Jet, Flowing Well, Other (Describe) _____		
POWER TYPE (Circle One): <input checked="" type="radio"/> Electric, Tractor, Diesel, Gasoline, Butane, Other (Describe) _____		
Pump Capacity (GPM) <i>18</i>	No. of Stages <i>20</i>	Setting Depth <i>130</i> FT.
PUMP TEST		
Well yielded _____ GPM with a drawdown of _____ ft. after _____ hours of pumping		

WELL DATA		
Well Depth <i>165</i>	Casing Diameter (In.) <i>4</i>	Casing Length (Ft.) <i>155</i>
Type of Casing <i>PVC</i>	Hole Depth <i>165</i>	Depth to Static Water Level <i>100</i>
TYPE OF COMPLETION: (Circle One or More): <input checked="" type="radio"/> Gravel Packed, Underreamed, Telescoped, <input checked="" type="radio"/> Natural Development, Open Hole, Other _____		
Top of Lap Pipe or Reduction in Casing		
FEET <input type="checkbox"/> IF TELESCOPED OR MORE THAN ONE SCREEN: USE BACK PAGE		

LOG DATA	
TYPE OF LOG RUN (Circle One): <input checked="" type="radio"/> No Log Run, Electric, Gamma Ray, Density, Sonic, Neutron, Other (Describe) _____	
Name of Organization Running Log	

SCREEN DATA		
Diameter - Inches <i>4</i>	Length - Feet <i>10</i>	Slot Size - Inches <i>10/32</i>
Screen Type <i>PVC</i>	Depth to Bottom - Feet <i>5</i>	

GEOLOGIC DATA (Office Use Only)			
Surface Elev.	Geologic Unit	Unit Thickness	Depth to Top
Subs. SWL	Date	Analysis	Aquifer Test


Driller's Remarks

DESCRIPTION OF FORMATIONS ENCOUNTERED	FROM	TO	DESCRIPTIONS (Continued)	FROM	TO
<i>Red Clay</i>	<i>0</i>	<i>15</i>	<div style="font-size: 2em; font-weight: bold; opacity: 0.5;">RECEIVED</div> <div style="font-size: 1.5em; font-weight: bold; margin-top: 10px;">SEP 14 1988</div> <div style="font-weight: bold; margin-top: 10px;">Department of Natural Resources Bureau of Land & Water Resources</div>		
<i>Red Sand</i>	<i>15</i>	<i>50</i>			
<i>Gravel</i>	<i>50</i>	<i>75</i>			
<i>White Sand</i>	<i>75</i>	<i>165</i>			

IF MORE SPACE IS NEEDED, USE BACK

If well telescopes please sketch and show depths.

GROUND LEVEL

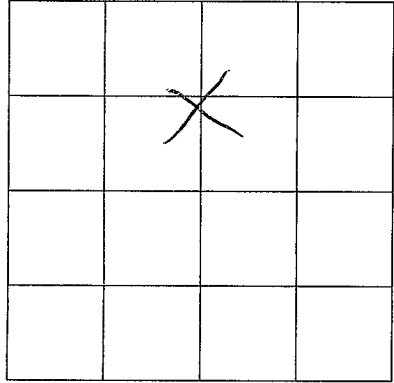

SECTION

13

Please indicate well location X.

ADDITIONAL INFORMATION

If more than one screen,
show location of each on sketch.