

MISSISSIPPI DEPARTMENT OF ENVIRONMENTAL QUALITY  
Bureau of Land and Water Resources

P. O. Box 10631  
Jackson, MS 39289-0631  
WATER WELL DRILLERS LOG

COUNTY WELL LOCATED  
Parola

WELL NUMBER  
C

CODED

DATE WELL COMPLETED  
7-3-91

**TATE**

PERMIT NUMBER  
**HICKS WELL CO.**

NAME OF DRILLING FIRM  
**HT. 1 BOX 157**

**SENATOBIA, MS 38668**

NAME & MAILING ADDRESS OF LANDOWNER  
Troy Collier

Rt 1 Box 279

Como Ms 38619

WELL LOCATION: SEC 3 TOWNSHIP 4 RANGE 6

DISTANCE 18 Miles DIRECTION NE of NEAREST TOWN Senatobia

OTHER LANDMARK

WELL PURPOSE:  Home,  Irrigation,  Municipal,  Industrial,  Fish Pond, etc.

PUMP DATA

PUMP TYPE (Circle One):  
 Submersible,  Turbine,  Jet,  Flowing Well,  
Other (Describe) \_\_\_\_\_

POWER TYPE (Circle One):  
 Electric,  Tractor,  Diesel,  Gasoline,  Butane,  
Other (Describe) \_\_\_\_\_ H/P 1/2

Pump Capacity (GPM) 10 No. of Stages 9 Setting Depth 135 FT.

PUMP TEST

Well yielded \_\_\_\_\_ GPM with  
a drawdown of \_\_\_\_\_ ft.  
after \_\_\_\_\_ hours of pumping

WELL DATA

Well Depth <u>175</u>	Casing Diameter (In.) <u>4</u>	Casing Length (Ft.) <u>165</u>
Type of Casing <u>PVC</u>	Hole Depth <u>175</u>	Depth to Static Water Level <u>120</u>

TYPE OF COMPLETION: (Circle One or More):  
 Gravel Packed,  Underreamed,  Telescoped,  
 Natural Development,  Open Hole,  Other

Top of Lap Pipe or Reduction in Casing

FEET IF TELESCOPED OR MORE THAN ONE SCREEN: USE BACK PAGE

LOG DATA

TYPE OF LOG RUN (Circle One):  
 No Log Run,  Electric,  Gamma Ray,  Density,  Sonic,  Neutron,  
Other (Describe) \_\_\_\_\_

Name of Organization Running Log

SCREEN DATA

Diameter - Inches <u>4</u>	Length - Feet <u>10'</u>	Slot Size - Inches <u>013</u>
Screen Type <u>PVC</u>	Depth to Bottom - Feet <u>101</u>	

GEOLOGIC DATA (Office Use Only)

Surface Elev.	Geologic Unit	Unit Thickness	Depth to Top
Subs. SWL	Date	Analysis	Aquifer Test

Driller's Remarks

DESCRIPTION OF FORMATIONS ENCOUNTERED	FROM	TO
<u>Dirt</u>	<u>0</u>	<u>10</u>
<u>gravel</u>	<u>10</u>	<u>45</u>
<u>Clay + sand</u>	<u>45</u>	<u>120</u>
<u>W. sand</u>	<u>120</u>	<u>175</u>

FORMATIONS (Continued)

**15**


**SEP 16 1991**

**Dept. of Environmental Quality**  
**Bureau of Land & Water Resources**

IF MORE SPACE IS NEEDED, USE BACK

If well telescopes please  
sketch and show depths.

GROUND LEVEL

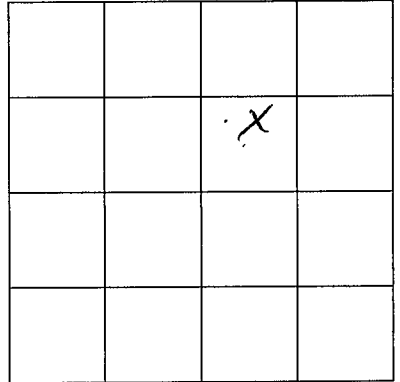

SECTION \_\_\_\_\_

Please indicate well location X.

ADDITIONAL INFORMATION

If more than one screen,  
show location of each on sketch.