

MISSISSIPPI DEPARTMENT OF ENVIRONMENTAL QUALITY

Office of Land and Water Resources

P. O. Box 10631
Jackson, MS 39289-0631
WATER WELL DRILLERS LOG

COUNTY WELL LOCATED <i>Itte</i>	
WELL NUMBER <i>C</i>	CODED
DATE WELL COMPLETED <i>2/3/94</i> <i>6-16-94</i>	

PERMIT NUMBER HICKS WELL CO.
NAME OF DRILLING FIRM RT. 1 BOX 157 SENATOBIA, MS 38668

NAME & MAILING ADDRESS OF LANDOWNER <i>Rodger webb</i> <i>RT 3 Box 316 BB</i> <i>Coldwater MS</i>			
WELL LOCATION:	SEC	TOWNSHIP	RANGE
	<i>14</i>	<i>4</i>	<i>N 6 E</i>
DISTANCE	DIRECTION	NEAREST TOWN	
<i>16</i> Miles	<i>NE</i>	of <i>Senatobia</i>	
OTHER LANDMARK			
WELL PURPOSE (<input checked="" type="radio"/> Home) Irrigation, Municipal, Industrial, Fish Pond, etc.			

PUMP DATA		
PUMP TYPE (Circle One): <input checked="" type="radio"/> Submersible, Turbine, Jet, Flowing Well, Other (Describe) _____		
POWER TYPE (Circle One): <input checked="" type="radio"/> Electric, Tractor, Diesel, Gasoline, Butane, Other (Describe) _____ H/P <i>1/2</i>		
Pump Capacity (GPM) <i>10</i>	No. of Stages	Setting Depth <i>130</i> FT.
PUMP TEST		
Well yielded _____ GPM with a drawdown of _____ ft. after _____ hours of pumping		

WELL DATA		
Well Depth <i>180'</i>	Casing Diameter (In.) <i>4"</i>	Casing Length (Ft.) <i>170'</i>
Type of Casing <i>Pvc</i>	Hole Depth <i>180'</i>	Depth to Static Water Level <i>100'</i>
TYPE OF COMPLETION: (Circle One or More): <input checked="" type="radio"/> Gravel Packed, <input type="radio"/> Underreamed, <input type="radio"/> Telescoped, <input type="radio"/> Natural Development, <input type="radio"/> Open Hole, <input type="radio"/> Other (Describe) _____		

LOG DATA	
TYPE OF LOG RUN (Circle One): <input type="radio"/> No Log Run, <input type="radio"/> Electric, <input type="radio"/> Gamma Ray, <input type="radio"/> Density, <input type="radio"/> Sonic, <input type="radio"/> Neutron, Other (Describe) _____	
Name of Organization Running Log	

WELL GROUTED TO A DEPTH OF <i>3</i> FEET Type Grout (circle one): Cement, Bentonite, or Mix

GEOLOGIC DATA (Office Use Only)			
Surface Elev.	Geologic Unit	Unit Thickness	Depth to Top
Subs. SWL	Date	Analysis	Aquifer Test

SCREEN DATA		
Diameter - Inches <i>4"</i>	Length - Feet <i>10'</i>	Slot Size - Inches <i>.013</i>
Screen Type <i>Pvc</i>	Depth to Bottom - Feet <i>180'</i>	

Driller's Remarks	
Top of Lap Pipe or Reduction in Casing	
FEET	IF TELESCOPED OR MORE THAN ONE SCREEN: USE BACK PAGE

DESCRIPTION OF FORMATIONS ENCOUNTERED	FROM	TO	FORMATIONS (Continued)	FROM	TO
<i>Red sand</i>	<i>0</i>	<i>60</i>			
<i>Sand & clay</i>	<i>60</i>	<i>100</i>			
<i>clay</i>	<i>100</i>	<i>120</i>			
<i>white sand</i>	<i>120</i>	<i>180</i>			

RECEIVED


MAR 13 1995

Dept. of Environmental Quality
Office of Land & Water Resources

IF MORE SPACE IS NEEDED, USE BACK

If well telescopes please sketch and show depths.

GROUND LEVEL

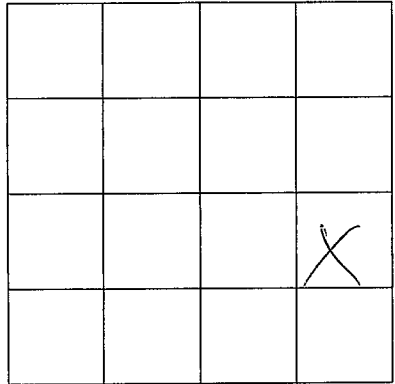

SECTION 14

Please indicate well location X.

ADDITIONAL INFORMATION

If more than one screen,
show location of each on sketch.