

MISSISSIPPI DEPARTMENT OF ENVIRONMENTAL QUALITY

Office of Land and Water Resources

COUNTY WELL LOCATED
TATE
WELL NUMBER C CODED
DATE WELL COMPLETED
2/23/95
8-27-95

PERMIT NUMBER
HICKS WELL CO.
NAME OF DRILLING FIRM
RT. 1 BOX 157
SENATOBIA, MS 38668

P. O. Box 10631
Jackson, MS 39289-0631
WATER WELL DRILLERS LOG

NAME & MAILING ADDRESS OF LANDOWNER
Donna Thompson
RT-3 BOX 147
Coldwater, MS
WELL LOCATION: SEC 7 TOWNSHIP 4 RANGE 6
DISTANCE 8 Miles E DIRECTION of Coldwater NEAREST TOWN
OTHER LANDMARK
WELL PURPOSE Home Irrigation, Municipal, Industrial, Fish Pond, etc.

PUMP DATA
PUMP TYPE (Circle One):
 Submersible, Turbine, Jet, Flowing Well,
Other (Describe)
POWER TYPE (Circle One):
Electric, Tractor, Diesel, Gasoline, Butane,
Other (Describe) H/P
Pump Capacity (GPM) 10 No. of Stages 9 Setting Depth 120 FT.
PUMP TEST
Well yielded _____ GPM with
a drawdown of _____ ft.
after _____ hours of pumping

WELL DATA
Well Depth 160' Casing Diameter (In.) 4" Casing Length (Ft.) 150
Type of Casing PVC Hole Depth 160' Depth to Static Water Level 100
TYPE OF COMPLETION: (Circle One or More):
 Gravel Packed, Underreamed, Telescoped,
Natural Development, Open Hole, Other
(Describe)
WELL GROUTED TO A DEPTH OF 10 FEET
Type Grout (circle one): Cement, Bentonite, or Mix

LOG DATA
TYPE OF LOG RUN (Circle One): No Log Run,
Electric, Gamma Ray, Density, Sonic, Neutron,
Other (Describe)
Name of Organization Running Log

SCREEN DATA
Diameter - Inches 4" Length - Feet 10' Slot Size - Inches 0.13
Screen Type PVC Depth to Bottom - Feet 10'

GEOLOGIC DATA (Office Use Only)

Surface Elev.	Geologic Unit	Unit Thickness	Depth to Top

Subs. SWL	Date	Analysis	Aquifer Test

Driller's Remarks
Top of Lap Pipe or Reduction in Casing
FEET IF TELESCOPED OR MORE THAN ONE SCREEN: USE BACK PAGE


DESCRIPTION OF FORMATIONS ENCOUNTERED	FROM	TO	FORMATIONS (Continued)	FROM	TO
<u>Sand & clay</u>	<u>0</u>	<u>80</u>	RECEIVED JUL 24 1995		
<u>clay</u>	<u>80</u>	<u>100</u>			
<u>white sand</u>	<u>100</u>	<u>160</u>			

IF MORE SPACE IS NEEDED, USE BACK

Dept. of Environmental Quality
Office of Land & Water Resources

If well telescopes please sketch and show depths.

GROUND LEVEL

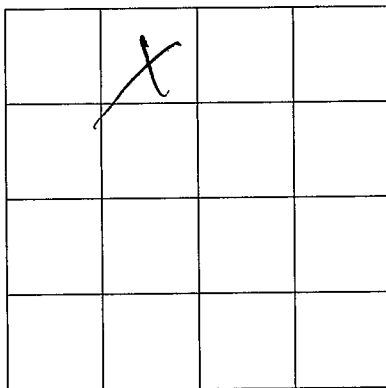

SECTION

7

Please indicate well location X.

ADDITIONAL INFORMATION

If more than one screen,
show location of each on sketch.