

MISSISSIPPI DEPARTMENT OF NATURAL RESOURCES

Bureau of Land and Water Resources

Southport Mall

P.O. Box 10631

Jackson, Mississippi 39209

WATER WELL DRILLERS LOG

Tate
 C 2136
 4-18-85

HICKS WELL COMPANY

4-18 19 85
 date well completed

RT. 1 - firm name

Tate
 county well located

LANDOWNER: Tera Louise Davis

description of formations encountered

from to

1710 Carlyle Dr
 Memphis TN 38127
 (mailing address)

Red clay	0	10
Red sand	10	30
White sand	30	45

WELL LOCATION:

sec. 36 T 4 N R 6 E
 2 miles West of BETT
 (distance) (direction) (nearest town)

WELL PURPOSE: HOME
 (home, irrigation, municipal, industrial)

WELL COMPLETION DATA:

- (1) diameter (inches) 4"
- (2) total depth (feet) 140'
- (3) static water level (feet) 60 below above top of ground.
- (4) casing PVC, 130', (material) (depth)
 4" if telescope see back. (size)
- (5) screen 10', 130' (length) (depth to top)
 10, PVC (size) (material)
- (6) pump 1/2, 10 (HP) (yield gpm)
 220 V (type power)
- (7) electric log NO (yes or no)
 (organization running log)
- (8) how well bottom plugged Cap


DRILLERS REMARKS:

RECEIVED
 JUL 11 1985

Department of Natural Resources
 Bureau of Land & Water Resources

If well telescopes please sketch and show depths.

GROUND LEVEL

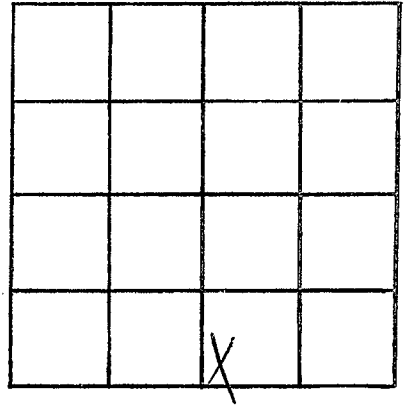

SECTION 36

Please indicate well location X.

ADDITIONAL INFORMATION

If more than one screen,
show locations of each on sketch.