

MISSISSIPPI DEPARTMENT OF ENVIRONMENTAL QUALITY

Office of Land and Water Resources

P. O. Box 10631
 Jackson, MS 39289-0631
 WATER WELL DRILLERS LOG

COUNTY WELL LOCATED
TALe
 WELL NUMBER C 2141 CODED
 DATE WELL COMPLETED
8-14-95

PERMIT NUMBER
HICKS WELL CO.
 NAME OF DRILLING FIRM BOX 157
SENATOBIA, MS 39668

NAME & MAILING ADDRESS OF LANDOWNER Slocum
David Slocum
8002 Co. Line Rd
Coldwater Ms.
 WELL LOCATION: SEC 28 TOWNSHIP 4 RANGE 6
 DISTANCE 2 Miles West DIRECTION of NEAREST TOWN
 OTHER LANDMARK
 WELL PURPOSE Home Irrigation, Municipal, Industrial, Fish Pond, etc.

PUMP DATA
 PUMP TYPE (Circle One):
 Submersible Turbine Jet Flowing Well,
 Other (Describe) _____
 POWER TYPE (Circle One):
 Electric Tractor Diesel Gasoline Butane.
 Other (Describe) _____ H/P 34
 Pump Capacity (GPM) 10 No. of Stages 9 Setting Depth 100 FT.
 PUMP TEST
 Well yielded _____ GPM with
 a drawdown of _____ ft.
 after _____ hours of pumping

WELL DATA
 Well Depth 150' Casing Diameter (In.) 4" Casing Length (Ft.) 140'
 Type of Casing PVC Hole Depth 150' Depth to Static Water Level 60'

LOG DATA
 TYPE OF LOG RUN (Circle One):
 No Log Run, Electric, Gamma Ray, Density, Sonic, Neutron, Other (Describe) _____
 Name of Organization Running Log _____

TYPE OF COMPLETION: (Circle One or More):
 Gravel Packed, Underreamed, Telescoped, Natural Development, Open Hole, Other (Describe) _____

WELL GROUTED TO A DEPTH OF 10 FEET
 Type Grout (circle one): Cement, Bentonite, or Mix

GEOLOGIC DATA (Office Use Only)

Surface Elev.	Geologic Unit	Unit Thickness	Depth to Top
Subs. SWL	Date	Analysis	Aquifer Test

SCREEN DATA

Diameter - Inches	Length - Feet	Slot Size - Inches
<u>4"</u>	<u>10'</u>	<u>.013</u>
Screen Type	Depth to Bottom - Feet	
<u>PVC</u>	<u>10'</u>	

Driller's Remarks
 Top of Lap Pipe or Reduction in Casing
 FEET IF TELESCOPED OR MORE THAN ONE SCREEN: USE BACK PAGE


DESCRIPTION OF FORMATIONS ENCOUNTERED	FROM	TO	FORMATIONS (Continued):	FROM	TO
<u>SAND & CLAY</u>	<u>0</u>	<u>80</u>			
<u>White SAND</u>	<u>80</u>	<u>150</u>			

FEB 05 1996

IF MORE SPACE IS NEEDED, USE BACK

If well telescopes please
sketch and show depths.

GROUND LEVEL

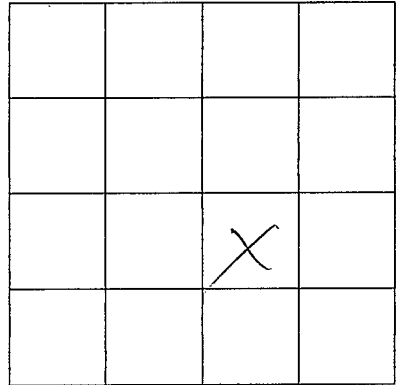

SECTION 28

Please indicate well location X.

ADDITIONAL INFORMATION

If more than one screen,
show location of each on sketch.