

MISSISSIPPI DEPARTMENT OF ENVIRONMENTAL QUALITY

Office of Land and Water Resources

P. O. Box 10631
Jackson, MS 39289-0631
WATER WELL DRILLERS LOG

COUNTY WELL LOCATED TATE	
WELL NUMBER 22152	CODED
DATE WELL COMPLETED 7-29-99	

PERMIT NUMBER
NAME OF DRILLING FIRM HICKS WELL CO.

NAME & MAILING ADDRESS OF LANDOWNER Jeremy or Amy Massey 90 Smith Rd. Coldwater, MS 38618		
WELL LOCATION: SEC	TOWNSHIP	RANGE
6	4 N	6 E
DISTANCE	DIRECTION	NEAREST TOWN
1 1/2 Miles	W	of Greenleaf
OTHER LANDMARK		
WELL PURPOSE: <input checked="" type="checkbox"/> Home, <input type="checkbox"/> Irrigation, <input type="checkbox"/> Municipal, <input type="checkbox"/> Industrial, <input type="checkbox"/> Fish Pond, etc.		

PUMP DATA		
PUMP TYPE (Circle One): <input checked="" type="checkbox"/> Submersible, <input type="checkbox"/> Turbine, <input type="checkbox"/> Jet <input type="checkbox"/> Flowing Well, Other (Describe) _____		
POWER TYPE (Circle One): <input checked="" type="checkbox"/> Electric, <input type="checkbox"/> Tractor, <input type="checkbox"/> Diesel, <input type="checkbox"/> Gasoline, <input type="checkbox"/> Butane, Other (Describe) _____ H/P 1/2		
Pump Capacity (GPM) 10	No. of Stages	Setting Depth 130 FT.
PUMP TEST		
Well yielded _____ GPM with a drawdown of low _____ ft. Test		
after _____ hours of pumping		

WELL DATA		
Well Depth 135	Casing Diameter (In.) 4	Casing Length (Ft.) 125
Type of Casing PVC	Hole Depth 135	Depth to Static Water Level 80

LOG DATA	
TYPE OF LOG RUN (Circle One): <input checked="" type="checkbox"/> No Log Run, <input type="checkbox"/> Electric, <input type="checkbox"/> Gamma Ray, <input type="checkbox"/> Density, <input type="checkbox"/> Sonic, <input type="checkbox"/> Neutron, Other (Describe) _____	
Name of Organization Running Log	

TYPE OF COMPLETION: (Circle One or More): <input checked="" type="checkbox"/> Gravel Packed, <input type="checkbox"/> Underreamed, <input type="checkbox"/> Telescoped, <input type="checkbox"/> Natural Development, <input type="checkbox"/> Open Hole, <input type="checkbox"/> Other (Describe) _____		
--	--	--

GEOLOGIC DATA (Office Use Only)			
Surface Elev.	Geologic Unit	Unit Thickness	Depth to Top
Subs. SWL	Date	Analysis	Aquifer Test

WELL GROUTED TO A DEPTH OF 3 FEET Type Grout (circle one): <input checked="" type="checkbox"/> Cement, <input type="checkbox"/> Bentonite, or Mix

Driller's Remarks	
Top of Lap Pipe or Reduction in Casing	
FEET	IF TELESCOPED OR MORE THAN ONE SCREEN: USE BACK PAGE


SCREEN DATA		
Diameter - Inches 4	Length - Feet 10	Slot Size - Inches .014
Screen Type PVC slot	Depth to Bottom - Feet 125	

DESCRIPTION OF FORMATIONS ENCOUNTERED	FROM	TO
Red + White Clay	0	15
Red Clay + Sand	15	30
Mixed Clay	30	80
White Sand	80	135

FORMATIONS (Continued)	FROM	TO
RECEIVED		
SEP 20 1999		
Dept of Environmental Quality Office of Land and Water Resources		
IF MORE SPACE IS NEEDED, USE BACK		

If well telescopes please sketch and show depths.

GROUND LEVEL

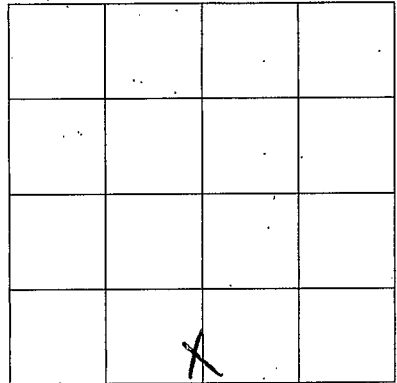

SECTION 6

Please indicate well location X.

ADDITIONAL INFORMATION

If more than one screen, show location of each on sketch.