

MISSISSIPPI DEPARTMENT OF ENVIRONMENTAL QUALITY

Office of Land and Water Resources

P. O. Box 10631
Jackson, MS 39289-0631
WATER WELL DRILLERS LOG

COUNTY WELL LOCATED TATE	
WELL NUMBER C2154	CODED
DATE WELL COMPLETED 8-4-99	

PERMIT NUMBER
NAME OF DRILLING FIRM HICKS WELL CO.

NAME & MAILING ADDRESS OF LANDOWNER John Boyd 637 Hassell Rd. Coldwater, MS 38618			
WELL LOCATION:	SEC	TOWNSHIP	RANGE
	17	4	N 6 E
DISTANCE	DIRECTION	NEAREST TOWN	
2 Miles	NW	of Independence	
OTHER LANDMARK			
WELL PURPOSE: Home, Irrigation, Municipal, Industrial, Fish Pond, etc. Lodge			

PUMP DATA		
PUMP TYPE (Circle One): <u>Submersible</u> Turbine; Jet Flowing Well, Other (Describe) _____		
POWER TYPE (Circle One): Electric, Tractor, Diesel, Gasoline, Butane, Other (Describe) _____ H/P 1/2		
Pump Capacity (GPM) 10	No. of Stages	Setting Depth 80 FT.
PUMP TEST Well yielded _____ GPM with a drawdown of no test ft. after _____ hours of pumping		

Well Depth 115	Casing Diameter (In.) 4	Casing Length (Ft.) 105
Type of Casing PVC	Hole Depth 115	Depth to Static Water Level 10

TYPE OF LOG RUN (Circle One): <u>No Log Run</u> Electric, Gamma Ray, Density, Sonic, Neutron, Other (Describe) _____	
Name of Organization Running Log	

TYPE OF COMPLETION: (Circle One or more):
Gravel Packed, Underreamed, Telescoped,
Natural Development, Open Hole, Other
(Describe) _____

GEOLOGIC DATA (Office Use Only)			
Surface Elev.	Geologic Unit	Unit Thickness	Depth to Top
Subs. SWL	Date	Analysis	Aquifer Test

WELL GROUTED TO A DEPTH OF **3** FEET
Type Grout (circle one): Cement Bentonite or Mix

SCREEN DATA		
Diameter - Inches 4	Length - Feet 10	Slot Size - Inches 1014
Screen Type PVC Slot	Depth to Bottom - Feet 105	


Driller's Remarks			
Top of Lap Pipe or Reduction in Casing			
FEET			
IF TELESCOPED OR MORE THAN ONE SCREEN: USE BACK PAGE			

DESCRIPTION OF FORMATIONS ENCOUNTERED	FROM	TO
Red + White Clay	0	15
Gravel Sand	15	35
White Sand + Clay	35	70
White Sand	70	115

FORMATIONS (Continued)	FROM	TO
RECEIVED		
SEP 20 1999		
Dept. of Environmental Quality Office of Land & Water Resources		
IF MORE SPACE IS NEEDED, USE BACK		

If well telescopes please sketch and show depths.

GROUND LEVEL

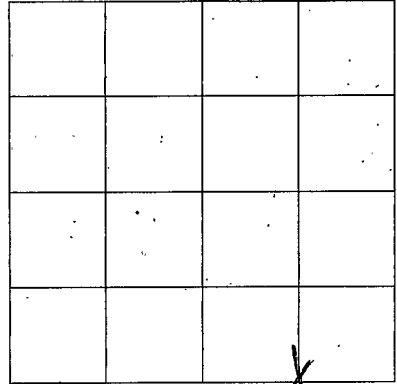

SECTION 17

Please indicate well location X.

ADDITIONAL INFORMATION

If more than one screen,
show location of each on sketch.