

MISSISSIPPI DEPARTMENT OF ENVIRONMENTAL QUALITY
Office of Land and Water Resources

P. O. Box 10631
Jackson, MS 39289-0631
WATER WELL DRILLERS LOG

COUNTY WELL LOCATED TATE	
WELL NUMBER C 2155	CODED
DATE WELL COMPLETED 12-9-99	

PERMIT NUMBER
NAME OF DRILLING FIRM HICKS WELL CO.

NAME & MAILING ADDRESS OF LANDOWNER Michael or Jennifer Davis			
429 Conway Rd.			
Co. Hwate, MS 38618			
WELL LOCATION	SEC	TOWNSHIP	RANGE
	24	4	N 6 E
DISTANCE	DIRECTION	NEAREST TOWN	
1 Miles	NE	INDEPENDENCE	
OTHER LANDMARK			
WELL PURPOSE <u>Home Irrigation</u> , Municipal, Industrial, Fish Pond, etc.			

PUMP DATA			
PUMP TYPE (Circle One): <u>Submersible</u> , Turbine, Jet, Flowing Well, Other (Describe)			
POWER TYPE (Circle One): <u>Electric</u> , Tractor, Diesel, Gasoline, Butane, Other (Describe) <u>H/P</u>			
Pump Capacity (GPM) 10	No of Stages	Setting Depth 100	FT.
PUMP TEST			
Well yielded _____ GPM with a drawdown of <u>10</u> ft. after _____ hours of pumping			

WELL DATA		
Well Depth 134	Casing Diameter (In.) 4	Casing Length (Ft.) 124
Type of Casing PVC	Hole Depth 134	Depth to Static Water Level 80
TYPE OF COMPLETION: (Circle One or More): <u>Gravel Packed</u> , Underreamed, Telescoped, Natural Development: Open Hole, Other (Describe)		

LOG DATA	
TYPE OF LOG RUN (Circle One): Electric, Gamma Ray, Density, Sonic, Neutron, Other (Describe) <u>No Log Run</u>	
Name of Organization Running Log	

WELL GROUTED TO A DEPTH OF 3 FEET
Type Grout (circle one): Cement, <u>Bentonite</u> , or Mix

GEOLOGIC DATA (Office Use Only)			
Surface Elev	Geologic Unit	Unit Thickness	Depth to Top
Subs. SWL	Date	Analysis	Aquifer Test
Driller's Remarks			

SCREEN DATA		
Diameter - Inches 4	Length - Feet 10	Slot Size - Inches .014
Screen Type PVC slot	Depth to Bottom - Feet 124	


Top of Lap Pipe or Reduction in Casing	FEET	IF TELESCOPED OR MORE THAN ONE SCREEN: USE BACK PAGE
--	------	--

DESCRIPTION OF FORMATIONS ENCOUNTERED	FROM	TO
Red & White Clay	0	10
Red Sand & Clay	10	45
Red Sand & Gravel	45	70
White Sand & Clay	70	110
White Sand	110	134

FORMATIONS (Continued)	FROM	TO
RECEIVED		
JAN 04 2000		
Dept. of Environmental Quality Office of Land & Water Resources		
IF MORE SPACE IS NEEDED, USE BACK		

If well telescopes please sketch and show depths.

GROUND LEVEL

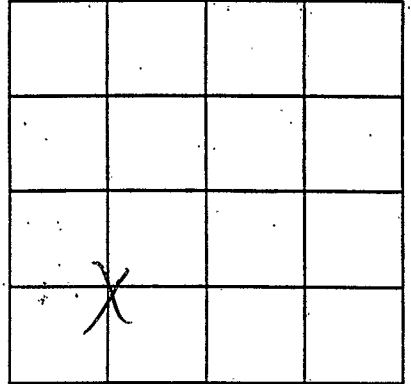

SECTION 24

Please indicate well location X.

ADDITIONAL INFORMATION

RECEIVED
2005-01-11

U.S. DEPARTMENT OF AGRICULTURE
NATIONAL WELL SURVEY

If more than one screen,
show location of each on sketch.