

C2196

Tate Co

D-26

12-5-69

MISSISSIPPI
 BOARD OF WATER COMMISSIONERS
 416 North State Street
 Jackson, Mississippi 39201

WATER WELL DRILLERS LOG

12-5-69
date well completed

1969 Leak Well Co
firm name

Tate
county well located

LANDOWNER: James Ferguson

description of formations encountered

from to

Independence
Miss.

Surface clay	1	15
Clay + sand	15	37
Thin sand + clay	37	80
Med coarse sand	80	140

(mailing address)

WELL LOCATION:

35 sec T-4 R-5 6 163
 1/4 miles S of Independence
 (distance) (direction) (nearest town)

WELL PURPOSE: Home
(home, irrigation, municipal, industrial)

WELL COMPLETION DATA:

- (1) diameter (inches) 4"
- (2) total depth (feet) 140'
- (3) static water level (feet) 45' below top of ground.
- (4) casing Plastic 130
(material) (depth)
if telescope see back.
(size)
- (5) screen 10' 130
(length) (depth to top)
4" Plastic
(size) (material)
- (6) pump 1 35
(HP) (yield gpm)
E-lee
(type power)
- (7) electric log no
(yes or no)
(organization running log)
- (8) how well bottom plugged Plastic

MAY 21 1969


MISS. Bd. of WATER COMM.

DRILLERS REMARKS:

Well capable of producing 509 gpm

If well telescopes please sketch and show depths.

GROUND LEVEL

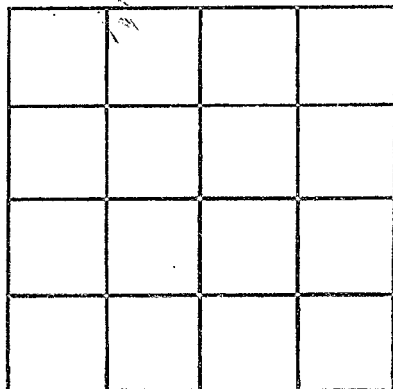

SECTION 5

Please indicate well location X.

ADDITIONAL INFORMATION

If more than one screen, show locations of each on sketch.