

TATE  
D4  
9-30-71

MISSISSIPPI  
BOARD OF WATER COMMISSIONERS  
416 North State Street  
Jackson, Mississippi 39201

DEC 8 1971

WATER WELL DRILLERS LOG

**CODED**

9-30  
date well completed

1971 Harris Bros.  
firm name


Tate  
county well located

LANDOWNER: <u>J.C. Dupes</u>	description of formations encountered	from	to
pt. 3 Coldwater (mailing address)			
WELL LOCATION: sec. <u>7</u> T. <u>4</u> N. R. <u>5</u> E <u>1</u> miles <u>W</u> of <u>Wapahilla</u> (distance) (direction) (nearest town)	<u>top soil</u>	<u>0</u>	<u>15</u>
	<u>red sand</u>	<u>15</u>	<u>40</u>
	<u>white clay</u>	<u>40</u>	<u>65</u>
	<u>clay + sand</u>	<u>65</u>	<u>120</u>
	<u>course sand</u>	<u>120</u>	<u>130</u>
WELL PURPOSE: <u>home</u> (home, irrigation, municipal, industrial)			
WELL COMPLETION DATA: (1) diameter (inches) <u>4</u> (2) total depth (feet) <u>130</u> (3) static water level (feet) <u>80</u> <u>below</u> above top of ground. (4) casing <u>plastic</u> , <u>123</u> (material) (depth) <u>4</u> if telescope see back. (size) (5) screen <u>7</u> , <u>123</u> (length) (depth to top) <u>008</u> , <u>plastic</u> (size) (material) (6) pump <u>3/4</u> , <u>7</u> (HP) (yield gpm) <u>elec.</u> (type power) (7) electric log <u>no</u> (yes or no)  (organization running log) (8) how well bottom plugged <u>beck</u> <u>shot</u>			
DRILLERS REMARKS:			

**CODED**

If well telescopes please sketch and show depths.

GROUND LEVEL

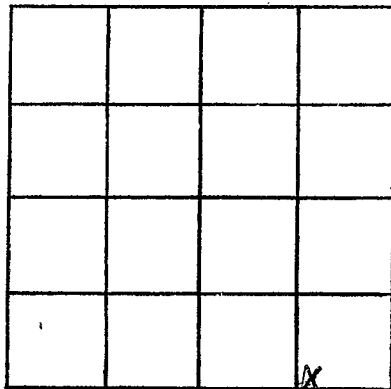

SECTION 7

Please indicate well location X.

ADDITIONAL INFORMATION

If more than one screen,  
show locations of each on sketch.