

TATE  
D5  
12-17-71

MISSISSIPPI  
BOARD OF WATER COMMISSIONERS  
416 North State Street  
Jackson, Mississippi 39201

APR 20 1972


WATER WELL DRILLERS LOG

12-17-1971 date well completed      Bob Smith firm name      Tate county well located

LANDOWNER:	description of formations encountered	from	to
Lester Reed Crosbyville, Miss. (mailing address)			
	red clay	5	30
	sand	30	120
WELL LOCATION:			
sec. <u>31</u> T <u>4</u> N R <u>5</u> E			
<u>1</u> miles <u>east</u> of <u>IND</u>			
(distance) (direction) of (nearest town)			
WELL PURPOSE:			
(home, irrigation, municipal, industrial) <u>None</u>			
WELL COMPLETION DATA:			
(1) diameter (inches) <u>4</u>			
(2) total depth (feet) <u>167</u>			
(3) static water level (feet) <u>100</u> below above top of ground.			
(4) casing <u>Plastic</u> , <u>167</u>			
(material) (depth)			
<u>        </u> if telescope see back.			
(size)			
(5) screen <u>20</u> <u>147</u>			
(length) (depth to top)			
<u>4</u> , <u>Plastic</u>			
(size) (material)			
(6) pump <u>1/2</u> <u>10</u>			
(HP) (yield gpm)			
<u>Electric</u>			
(type power)			
(7) electric log <u>no</u>			
(yes or no)			
<u>        </u>			
(organization running log)			
(8) how well bottom plugged <u>plugged</u>			
DRILLERS REMARKS:			

If well telescopes please sketch and show depths.

GROUND LEVEL

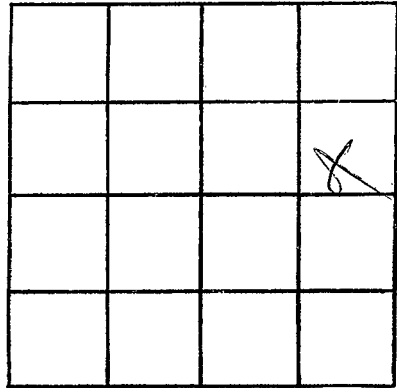

SECTION \_\_\_\_\_

Please indicate well location X.

ADDITIONAL INFORMATION

If more than one screen, show locations of each on sketch.