

TATE
D6
4-10-72

MISSISSIPPI
BOARD OF WATER COMMISSIONERS
416 North State Street
Jackson, Mississippi 39201

WATER WELL DRILLERS LOG

CODED

4-10 1972 G. & H. Well Co. TATE
date well completed firm name county well located

LANDOWNER: Hattie S. Dean
RT-2 Coldwater
Miss
(mailing address)

description of formations encountered	from	to
Red CLAY	0	15
Red CLAY	0	15
Red SAND	15	30
SANDY CLAY	30	60
WHITE SAND	60	150

WELL LOCATION:
sec. 20 T 4 N R. 5 E
13 miles EAST of Coldwater
(distance) (direction) (nearest town)

WELL PURPOSE: Home
(home, irrigation, municipal, industrial)

- WELL COMPLETION DATA:
- (1) diameter (inches) 4"
 - (2) total depth (feet) 150
 - (3) static water level (feet) 106 below above top of ground.
 - (4) casing PLASTIC, 1.25
(material) (depth)
 if telescope see back.
(size)
 - (5) screen 5', 10.5'
(length) (depth to top)
 (size) (material)
 - (6) pump 3/4 10 GPM
(HP) (yield gpm)
220 FIC
(type power)
 - (7) electric log NO
(yes or no)
 (organization running log)
 - (8) how well bottom plugged CAP

CODED

CODED


APR 12 1972

MISS. DEPT. OF
WATER CONTROL

DRILLERS REMARKS:

If well telescopes please sketch and show depths.

GROUND LEVEL

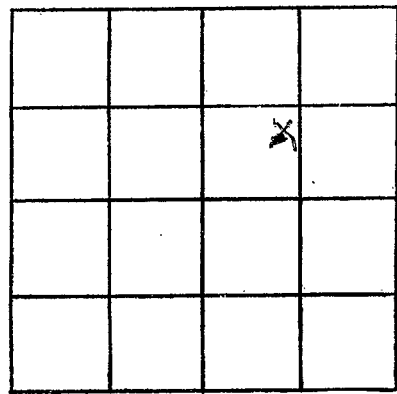

SECTION 13

Please indicate well location X.

ADDITIONAL INFORMATION

If more than one screen, show locations of each on sketch.