

TATE
D7
5-22-72

MISSISSIPPI
BOARD OF WATER COMMISSIONERS
416 North State Street
Jackson, Mississippi 39201

CODED

WATER WELL DRILLERS LOG

5-22-1972 date well completed C. & H. Well Co. firm name TATE county well located

| LANDOWNER: <u>Robert Lions</u> | description of formations encountered | from | to |
|-----------------------------------------------------------------------------------------------------------------------------------------------------|---------------------------------------|-----------|------------|
| <u>PT. 2 Coldwater Miss</u> | <u>Red CLAY</u> | <u>0</u> | <u>15</u> |
| | <u>Red SAND</u> | <u>15</u> | <u>45</u> |
| | <u>SANDY CLAY</u> | <u>45</u> | <u>60</u> |
| | <u>))))</u> | <u>60</u> | <u>90</u> |
| | <u>White SAND</u> | <u>90</u> | <u>150</u> |
| (mailing address) | | | |
| WELL LOCATION: sec. <u>30</u> T <u>4</u> N R <u>5</u> E <u>12</u> miles <u>E</u> of <u>Coldwater</u> (distance) (direction) (nearest town) | | | |
| WELL PURPOSE: <u>HOMP</u> (home, irrigation, municipal, industrial) | | | |
| WELL COMPLETION DATA: | | | |
| (1) diameter (inches) <u>4"</u> | | | |
| (2) total depth (feet) <u>150</u> | | | |
| (3) static water level (feet) <u>78</u> ^{below} / ^{above} top of ground. | | | |
| (4) casing <u>PLASTIC</u> , <u>145</u> (material) (depth) | | | |
| (size) If telescope see back. | | | |
| (5) screen <u>5'</u> , <u>5'</u> (length) (depth to top) | | | |
| <u>4"</u> , <u>GRAVEL</u> (size) (material) | | | |
| (6) pump <u>3/4</u> , <u>10</u> (HP) (yield gpm) | | | |
| <u>220 Elec.</u> (type power) | | | |
| (7) electric log <u>NO</u> (yes or no) | | | |
| (organization running log) | | | |
| (8) how well bottom plugged <u>CAP</u> | | | |

CODED


JUN 1 1972

DRILLERS REMARKS:

MISS. ED. OF
WATER COMMISSIONERS

If well telescopes please sketch and show depths.

GROUND LEVEL

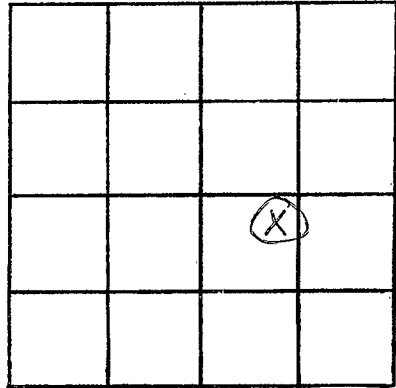

SECTION _____

Please indicate well location X.

ADDITIONAL INFORMATION

Lined area for entering additional information.

If more than one screen, show locations of each on sketch.