

Date
 D10
 3-1-68

MISSISSIPPI
 BOARD OF WATER COMMISSIONERS
 416 North State Street
 Jackson, Mississippi 39201

CODED
 CODED

WATER WELL DRILLERS LOG

3-1 1968 Harris Bros Date
 date well completed firm name county well located

LANDOWNER: R. L. Darnell
 rta 3
 Caldwellwater
 (mailing address)

description of formations encountered	from	to
top soil	0	20
fine sand	20	60
clay	60	80
coarse sand	80	120

WELL LOCATION:
 sec 7 T 4 N R 5 E
 7 miles NE of Independence
 (distance) (direction) (nearest town)

WELL PURPOSE: none
 (home, irrigation, municipal, industrial)

WELL COMPLETION DATA:

- (1) diameter (inches) 4"
- (2) total depth (feet) 120
- (3) static water level (feet) 80 ^{below} above top of ground.
- (4) casing Plastic, 106 (material) (depth)
 4" (size) if telescope see back.
- (5) screen 14' 106 (length) (depth to top)
 008 Plastic (size) (material)
- (6) pump 1 20 (HP) (yield gpm)
 elec (type power)
- (7) electric log All (yes or no)
- (organization running log)
- (8) how well bottom plugged back
 shut

CODED


DEC 23 1968

MISS. Bd. of
 WATER COMMISSIONERS

DRILLERS REMARKS:

If well telescopes please sketch and show depths.

GROUND LEVEL

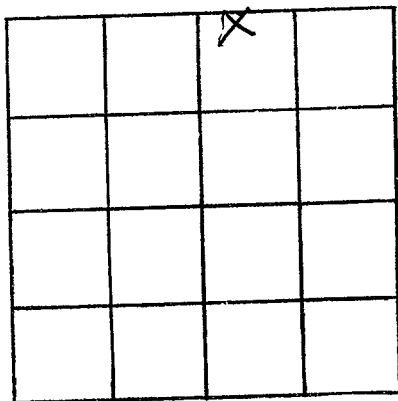

SECTION 7

Please indicate well location X.

ADDITIONAL INFORMATION

If more than one screen,
show locations of each on sketch.