

Tate Co.

D 13

8-68

MISSISSIPPI  
BOARD OF WATER COMMISSIONERS  
416 North State Street  
Jackson, Mississippi 39201

WATER WELL DRILLERS LOG

CODED

8-27

19

68 Harris Bros. Tate

date well completed

firm name

county well located

LANDOWNER

Leroy Crockett

description of formations  
encountered

from

to

pte. 2

Coldwater

(mailing address)

top soil

0

20

red sand

20

65

clay + sand

65

100

Independence Coarse sand

100

120

WELL LOCATION:

sec. 19 T. 4 N. R. 5 E.

5

5 miles

N E

(distance)

(direction)

(nearest town)

WELL PURPOSE:

home

(home, irrigation, municipal, industrial)

WELL COMPLETION DATA:

(1) diameter (inches)

4"

(2) total depth (feet)

120

(3) static water level (feet)

60

below  
above

(4) casing

Plastic

113

(material)

(depth)

4"

(size)

if telescope see back.

(5) screen

7'

(length)

113'

(depth, to top)

008

(size)

Plastic

(material)

(6) pump

3/4

(HP)

10

(yield gpm)

elec.

(type power)

(7) electric log

no

(yes or no)

(organization running log)

(8) how well bottom plugged

back

shot

DRILLERS REMARKS:


CODED

MAR 11 1969

MISS. BD. OF  
WATER COM.

If well telescopes please  
sketch and show depths.

GROUND LEVEL

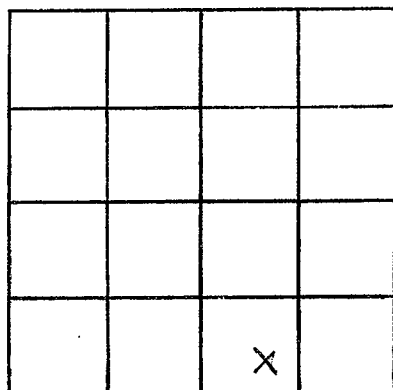

SECTION 19

Please indicate well location X.

ADDITIONAL INFORMATION

If more than one screen,  
show locations of each on sketch.