

**MISSISSIPPI  
BOARD OF WATER COMMISSIONERS  
416 North State Street  
Jackson, Mississippi 39201**

**CODED**

**WATER WELL DRILLERS LOG**

Date  
D16,  
7-25-69


July 25 th. 1969, W.A. Mason, Water Well Contractor      TATE  
date well completed      firm name      county well located

LANDOWNER: <u>Russell McLeod</u> by-order of <u>Sam Echels</u> <u>Route 3</u> <u>Coldwater Miss.</u>  (mailing address)	description of formations encountered	from	to
<b>WELL LOCATION:</b> sec. <u>9</u> T. <u>4</u> N. R. <u>5</u> E. <u>2-5-4</u> east <u>Wakefield</u> miles of (distance) (direction) (nearest town)	<u>Hard dirt</u>	<u>0</u>	<u>8</u>
<b>WELL PURPOSE:</b> <u>Home</u> (home, irrigation, municipal, industrial)	<u>ellow sand &amp; gravel</u>	<u>8</u>	<u>12</u>
<b>WELL COMPLETION DATA:</b> (1) diameter (inches) <u>Hole-12 in.</u>	<u>red sand &amp; some gravel</u>	<u>12-20</u>	
(2) total depth (feet) <u>63</u>	<u>ummy red sand</u>	<u>20</u>	<u>25</u>
(3) static water level (feet) <u>60</u> below above top of ground.	<u>red sand</u>	<u>25</u>	<u>31</u>
(4) casing <u>wood</u> <u>63</u> (material) (depth) if telescope see back. (size)	<u>red sand &amp; white rocks</u>	<u>31--33</u>	
(5) screen <u>none</u> (length) (depth to top) (size) (material)	<u>red tenish sand</u>	<u>33</u>	<u>36</u>
(6) pump <u>none</u> (HP) (yield gpm) (type power)	<u>white &amp; toned sand</u>	<u>36</u>	<u>45</u>
(7) electric log (yes or no) (organization running log)	<u>yellow sand</u>	<u>45</u>	<u>47</u>
(8) how well bottom plugged <u>not</u>	<u>white sand</u>	<u>47</u>	<u>50</u>
<b>DRILLERS REMARKS:</b> <u>square wood cybin 4 pes.</u> <u>1 x 6 cypress bght. of</u> <u>French E. Woods</u>	<u>white sand &amp; rocks</u>	<u>50</u>	<u>59</u>
	<u>water bearing grave</u>		
	<u>alt. size of eggs</u>	<u>59</u>	<u>63</u>
	<u>Soupy Fine sand</u>	<u>63</u>	<u>65</u>
	<u>&amp; WATER</u>		
	<u>hard white pipe</u>	<u>66</u>	<u>68</u>
	<u>Sand Rock</u>	<u>68'</u>	
	<u>10 FT. OR</u>		

AUG 5  
1969  
MISSISSIPPI  
STATE BOARD OF WATER COMMISSIONERS

If well telescopes please sketch and show depths.

GROUND LEVEL

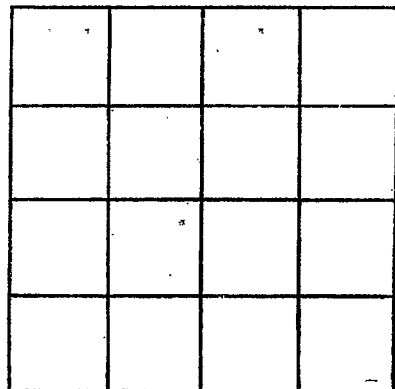

SECTION 9

Please indicate well location X.

ADDITIONAL INFORMATION

old well made by Johnny Mann  
approximately 30 years ago

If more than one screen,  
show locations of each on sketch.