

**MISSISSIPPI
BOARD OF WATER COMMISSIONERS
416 North State Street
Jackson, Mississippi 39201**

CODED

Late
D19
8-18-69

WATER WELL DRILLERS LOG

July 18th. 1969 W.A. Mason Water Well Contractor Tate

date well completed

firm name

county well located

LANDOWNER: Russell McLeod
By order Will Henry Jeffr
Route 3
Coldwater Miss.

(mailing address)

description of formations
as encountered

from

to

Extremely hard dirt 1 8

Hard sandish dirt 8 9

Dirty sand & gravel 9 11

Gray loose sand 11 12½

Hard red sand & gravel 12½-15

Hard red gravel 15 19

Deep gummy red sand 19 24

soft red sand 24 27

soft pink sand 27 34

white sticky sand 34 38

soft pink sand 38 46

white sand 46 72

damp pink sand 72 75

white coarse water bearing sand 75 85

fine white water bearing sand 85 93

coarse white water bearing sand 93 95

WELL LOCATION:

sec. 16 T. 4 N R. 5 E
2½ miles East Wakefield
(distance) (direction) (nearest town)

WELL PURPOSE: HOME

(home, irrigation, municipal, industrial)

WELL COMPLETION DATA:

(1) diameter (inches) 12 in. hole

(2) total depth (feet) 95

(3) static water level (feet) 75 below above top of ground.

(4) casing Styrene plastic 95
(material) (depth)

5 in. If telescope see back.
(size)

(5) screen none
(length) (depth to top)

(size) (material)

(6) pump none
(HP) (yield gpm)

(type power)

(7) electric log (yes or no)

(organization running log)

(8) how well bottom plugged rocks


DRILLERS REMARKS:

Put enough gravel rocks
in bottom to fill casing
8 in. to hold down sand

WATER 5
MASON-DRILLING
WATER 5000

If well telescopes please sketch and show depths.

GROUND LEVEL

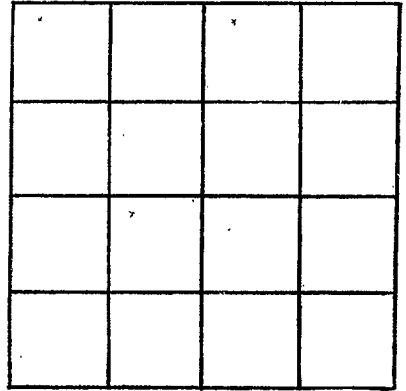

SECTION 16

Please indicate well location X.

ADDITIONAL INFORMATION

According to Russell McLeod a well was made at this location about 75 years ago by James J. Cooper & was doubled cased because of running sand.

If more than one screen, show locations of each on sketch.