

CODED

*Reurh Job*

MISSISSIPPI  
BOARD OF WATER COMMISSIONERS  
416 North State Street  
Jackson, Mississippi 39201

CODED

WATER WELL DRILLERS LOG

2ato  
D20  
8-18-69

August 12 th. 1969  
date well completed 19 W.A. Mason, Water Well Contractor TATE CO. firm name county well located

LANDOWNER: JIM ROGERS  
Route 3, Coldwater Miss.  
  
(mailing address)

description of formations encountered from to

WELL LOCATION:  
sec 21 T 4 N R 5 E  
1 1/2 miles S of North Wall Hill  
(distance) (direction) (nearest town)

WELL PURPOSE: Tenant House  
(home, irrigation, municipal, industrial)

W.H. Rogers

- WELL COMPLETION DATA:
- (1) diameter (inches) 4 in.
  - (2) total depth (feet) 66
  - (3) static water level (feet) 32 below top of ground
  - 4 in. styrene plastic XXXX
  - (4) casing (material) (depth) 33 ft.
  - \_\_\_\_\_ if telescope see back.  
(size)
  - (5) screen none  
(length) (depth to top)
  - (size) (material)
  - (6) pump none  
(HP) (yield gpm)
  - (type power)
  - (7) electric log (yes or no) \_\_\_\_\_  
(organization running log)
  - (8) how well bottom plugged NOT

white medium coarse water bearing sand 62 87


AUG 14 1969

DRILLERS REMARKS:

MISS. BD. OF  
WATER COM.

If well telescopes please sketch and show depths.

GROUND LEVEL

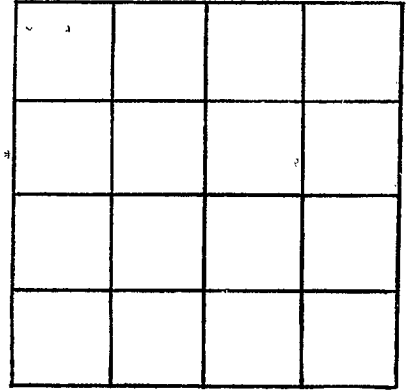

SECTION 21

Please indicate well location X.

ADDITIONAL INFORMATION

Put 4' in. styrene plastic  
inside old square curb in well  
and pumped it down about 20  
feet below old well  
old well was made by Charley  
Newsome about 15 years ago

If more than one screen,  
show locations of each on sketch.