

TATE
D 22
7-10-69

MISSISSIPPI
BOARD OF WATER COMMISSIONERS
416 North State Street
Jackson, Mississippi 39201

CODED

WATER WELL DRILLERS LOG

7-10 1969 date well completed
Harris Bros. Tate firm name
county well located

LANDOWNER: <u>W. H. Walker</u>	description of formations encountered	from	to
<u>Rt 2</u> <u>Coldwater</u> (mailing address)			
	<u>top soil</u>	<u>0</u>	<u>15</u>
	<u>plc gravel + sand</u>	<u>15</u>	<u>65</u>
	<u>fine sand</u>	<u>65</u>	<u>90</u>
	<u>Coarse sand</u>	<u>90</u>	<u>100</u>

WELL LOCATION:
sec 30 T 4 N R S E
S miles (distance) F (direction) of Independence (nearest town)

WELL PURPOSE: home
(home, irrigation, municipal, industrial)

WELL COMPLETION DATA:

- (1) diameter (inches) 4
- (2) total depth (feet) 100
- (3) static water level (feet) 60 ^{below} top of ground.
- (4) casing Plastic, 93 (material) (depth)
4" (size) if telescope see back.
- (5) screen 7', 93' (length) (depth to top)
008 Plastic (size) (material)
- (6) pump 3/4, 17 (HP) (yield gpm)
elec. (type power)
- (7) electric log no (yes or no)

(organization running log)


(8) how well bottom plugged back
shot

DRILLERS REMARKS:

NOV 2 1969
MISS. BD. OF
WATER COMMISSIONERS

If well telescopes please sketch and show depths.

GROUND LEVEL

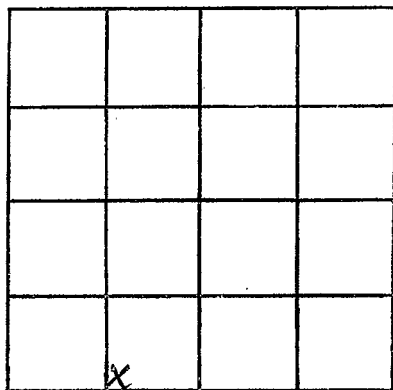

SECTION 30

Please indicate well location X.

ADDITIONAL INFORMATION

If more than one screen,
show locations of each on sketch.