

TATE
D23
8-28-69

MISSISSIPPI
BOARD OF WATER COMMISSIONERS
416 North State Street
Jackson, Mississippi 39201

CODED

WATER WELL DRILLERS LOG

8-28 1969 Harris Bros. Tate
date well completed firm name county well located

LANDOWNER: Water Rodgers
pto. 3
Coldwater
(mailing address)

description of formations encountered	from	to
top soil	0	20
red sand	20	50
clay + sand	50	115
coarse sand	115	130

WELL LOCATION:
sec 20 T 4 N R 5 E
7 miles NE of Independence
(distance) (direction) (nearest town)

WELL PURPOSE: none
(home, irrigation, municipal, industrial)

- WELL COMPLETION DATA:
- (1) diameter (inches) 4"
 - (2) total depth (feet) 130
 - (3) static water level (feet) 80 ^{below} top of ground.
 - (4) casing plastic, 123'
(material) (depth)
4 1/2" if telescope see back.
(size)
 - (5) screen 7', 123'
(length) (depth to top)
1/2", 7'
(size) (material)
 - (6) pump 3/4, 7
(HP) (yield gpm)
elec.
(type power)
 - (7) electric log no
(yes or no)

(organization running log)

(8) how well bottom plugged much
not


DRILLERS REMARKS:

DEC 29 1969

MISS. BD. OF
WATER COMM.

If well telescopes please sketch and show depths.

GROUND LEVEL

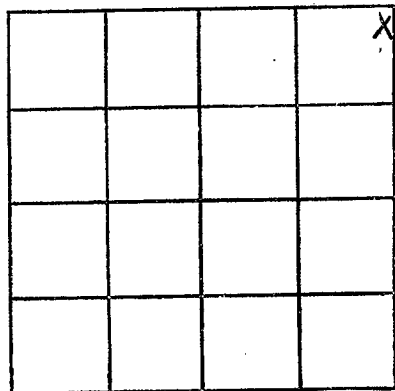

SECTION 20

Please indicate well location X.

ADDITIONAL INFORMATION

If more than one screen, show locations of each on sketch.