

TATE
D 24
9-15-69

MISSISSIPPI
BOARD OF WATER COMMISSIONERS
416 North State Street
Jackson, Mississippi 39201

CODED

WATER WELL DRILLERS LOG

9-15 date well completed 169 Harris Bros. firm name Tate county well located

LANDOWNER: R.E. Patrick

description of formations encountered

from to

pto 2
Coldwater
(mailing address)

top soil	0	20
per gravel + sand	20	65
clay + sand	65	90
coarse sand	90	100

WELL LOCATION:

sec. 32 T. 4 N. R. 5 E.
1 1/2 miles E of Bett
(distance) (direction) (nearest town)

WELL PURPOSE: home
(home, irrigation, municipal, industrial)

WELL COMPLETION DATA:

- (1) diameter (inches) 4
- (2) total depth (feet) 100
- (3) static water level (feet) 60 ^{below} above top of ground.
- (4) casing Plastic, 93'
(material) (depth)
4" (size) if telescope see back.
- (5) screen 7" 93'
(length) (depth to top)
008 Plastic
(size) (material)
- (6) pump 3/4 7
(HP) (yield gpm)
elec.
(type power)
- (7) electric log no
(yes or no)

(organization running log)

(8) how well bottom plugged was


DRILLERS REMARKS:

DEC 29 1969

MISS. BD. OF
WATER COM.

If well telescopes please sketch and show depths.

GROUND LEVEL

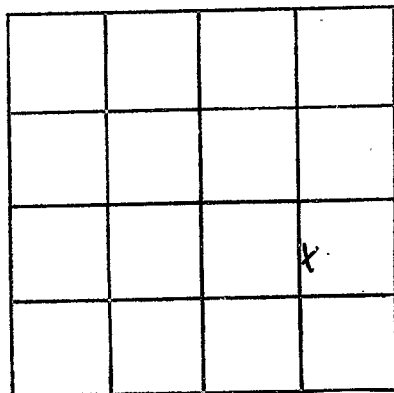

SECTION 32

Please indicate well location X.

ADDITIONAL INFORMATION

If more than one screen, show locations of each on sketch.