

MISSISSIPPI
 BOARD OF WATER COMMISSIONERS
 416 North State Street
 Jackson, Mississippi 39201

CODED

WATER WELL DRILLERS LOG

TATE
 D 25
 11-25-69

11-25-69 date well completed Harris Bros. firm name Tate county well located


LANDOWNER: <u>Russell Echols</u>	description of formations encountered	from	to
<u>Rte. 3 Box 232.</u>			
<u>Coldwater</u> (mailing address)	<u>top soil</u>	<u>0</u>	<u>20</u>
	<u>red sand</u>	<u>20</u>	<u>45</u>
	<u>clay & sand</u>	<u>45</u>	<u>120</u>
	<u>coarse sand</u>	<u>120</u>	<u>140</u>
WELL LOCATION: sec. <u>20</u> T <u>4</u> N R <u>9</u> E (S) (W) <u>6</u> miles <u>E</u> of <u>Anderson</u> (distance) (direction) (nearest town)			
WELL PURPOSE: <u>home</u> (home, irrigation, municipal, industrial)			
WELL COMPLETION DATA:			
(1) diameter (inches) <u>4</u>			
(2) total depth (feet) <u>140</u>			
(3) static water level (feet) <u>80</u> ^(below) above top of ground.			
(4) casing <u>Plastic</u> , <u>133'</u> (material) (depth)			
<u>4</u> if telescope see back. (size)			
(5) screen <u>7'</u> , <u>133'</u> (length) (depth to top)			
<u>008</u> , <u>Plastic</u> (size) (material)			
(6) pump <u>3/4</u> , <u>7</u> (HP) (yield gpm)			
<u>elec.</u> (type power)			
(7) electric log <u>no</u> (yes or no)			
(organization running log)			
(8) how well bottom plugged <u>back</u> <u>seals</u>			
DRILLERS REMARKS:			

DEC 20 1969

MISS. BD. OF
 WATER COMMISSIONERS

If well telescopes please sketch and show depths.

GROUND LEVEL

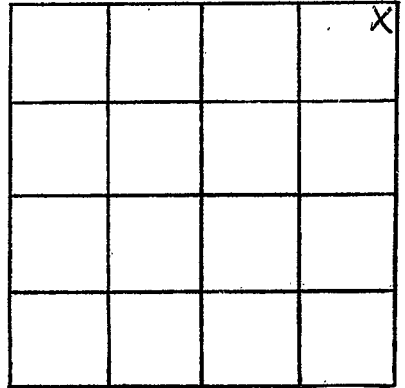

SECTION 20

Please indicate well location X.

ADDITIONAL INFORMATION

If more than one screen, show locations of each on sketch.