

Date  
 D 26  
 1-21-75

MISSISSIPPI  
 BOARD OF WATER COMMISSIONERS  
 416 North State Street  
 Jackson, Mississippi 39201

CODED

WATER WELL DRILLERS LOG

W.R. Mason, Water Well Co., Inc.

Date

1-21-75 19 date well completed      firm name      county well located

LANDOWNER:  
 Jerry Lowrey  
 Rt. 3, Calhoun, Miss.  
 (mailing address)

description of formations encountered	from	to
Clay left	70	18
red sand	18	50
white sand	50	165

WELL LOCATION:  
 sect 28 T 4 N R 5 E 15E  
 5 miles East of Independence  
 (distance) (direction) (nearest town)

WELL PURPOSE: Home  
 (home, irrigation, municipal, industrial)

CODED

WELL COMPLETION DATA:

(1) diameter (inches) 4"

(2) total depth (feet) 165'

(3) static water level (feet) 95' below top of ground.

(4) casing Plaster, 155' (material) (depth)  
 4" (size) if telescope see back.


(5) screen 10' 155' (length) (depth to top)  
 4" (size) Plaster (material)

(6) pump 3/4 10 (HP) (yield gpm)  
 electric (type power)

(7) electric log NO (yes or no)

(8) how well bottom plugged Cap on bottom


DRILLERS REMARKS:

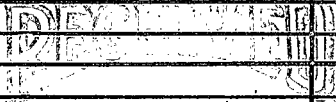

JUL 01 1975

If well telescopes please sketch and show depths.

GROUND LEVEL

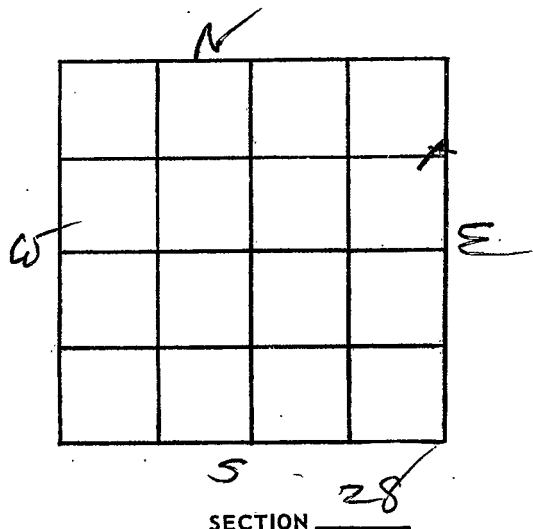

Please indicate well location X.

ADDITIONAL INFORMATION

If more than one screen, show locations of each on sketch.