

TATE

MISSISSIPPI  
BOARD OF WATER COMMISSIONERS  
416 North State Street  
Jackson, Mississippi 39201

**CODED**

WATER WELL DRILLERS LOG

*ATKINSON & FROST* *MARSHALL*

<del>1970</del>
D 29
70

date well completed 19 *ATKINSON & FROST* firm name *MARSHALL* county well located

LANDOWNER: *Price Thomas*  
*Byhalia Miss*  
(mailing address)

description of formations encountered	from	to
<i>Red Clay</i>	<i>0</i>	<i>10</i>
<i>White Sand</i>	<i>10</i>	<i>60</i>

WELL LOCATION:  
sec. *4* T. *4* N. R. *5* E  
*8* miles *SW* of *Watson*  
(distance) (direction) (nearest town)

WELL PURPOSE:  
(home, irrigation, municipal, industrial)

WELL COMPLETION DATA:

- (1) diameter (inches) *4 1/4*
- (2) total depth (feet) *60*
- (3) static water level (feet) *10* below top of ground.
- (4) casing *P.V.C.* *60*  
(material) (depth)
- (size) If telescope see back.
- (5) screen *5'* *35'*  
(length) (depth to top)  
*1 1/2" P.V.C. + SAND*  
(size) (material)
- (6) pump *1/2* *10*  
(HP) (yield gpm)
- (type power)
- (7) electric log (yes or no)
- (organization running log)
- (8) how well bottom plugged *CAP.*

**CODED**


OCT 13 1970

DRILLERS REMARKS:

MISS. BD. OF  
WATER COMM.

If well telescopes please sketch and show depths.

GROUND LEVEL

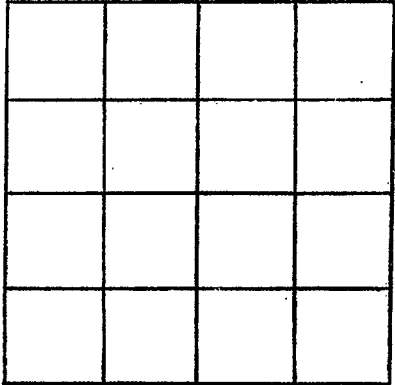

SECTION \_\_\_\_\_

Please indicate well location X.

ADDITIONAL INFORMATION

Lined area for additional information.

If more than one screen, show locations of each on sketch.