

TATE  
D30  
6-30-70

MISSISSIPPI  
BOARD OF WATER COMMISSIONERS  
416 North State Street  
Jackson, Mississippi 39201

**CODED**

WATER WELL DRILLERS LOG

6-20 1970 Harris Bros. Tate  
date well completed firm name county well located

LANDOWNER: J. W. Wallace  
Rt. 3  
Caldwater  
(mailing address)

description of formations encountered	from	to
top soil	0	25
clay & sand	15	100
course sand	100	115

WELL LOCATION:  
sec. 16 T. 4 N. R. 5 E.  
7/4 miles E of Wapele  
(distance) (direction) (nearest town)

WELL PURPOSE: none  
(home, irrigation, municipal, industrial)

- WELL COMPLETION DATA:
- (1) diameter (inches) 4"
  - (2) total depth (feet) 115
  - (3) static water level (feet) 80 <sup>below</sup> <sub>above</sub> top of ground.
  - (4) casing Plastic, 108,  
(material) (depth)  
4"  
(size) if telescope see back.
  - (5) screen 7', 108,  
(length) (depth to top)  
008, Plastic  
(size) (material)
  - (6) pump 3/4, 7  
(HP) (yield gpm)  
elec.  
(type power)
  - (7) electric log no  
(yes or no)
- (organization running log)
- (8) how well bottom plugged back  
shot

**CODED**


NOV 12 1970

DRILLERS REMARKS:

MISS. BD. OF  
WATER COMMISSIONERS

If well telescopes please sketch and show depths.

GROUND LEVEL

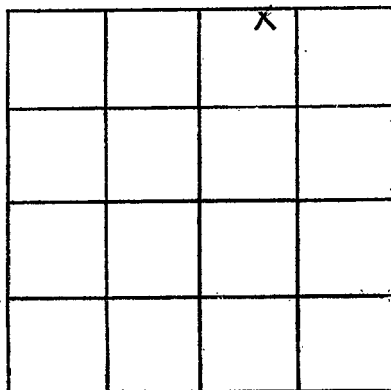

SECTION 16

Please indicate well location X.

ADDITIONAL INFORMATION

If more than one screen, show locations of each on sketch.