

TATE
D31
8-5-70

MISSISSIPPI
BOARD OF WATER COMMISSIONERS
416 North State Street
Jackson, Mississippi 39201

CODED

WATER WELL DRILLERS LOG

8-5-70 date well completed Harris Bros. firm name Tate county well located

LANDOWNER: Leon Farrow
pt. 2
Coldwater
(mailing address)

description of formations encountered	from	to
top soil	0	20
peg gravel & sand	20	45
clay & sand	45	120
course sand	120	140

WELL LOCATION:
sec. 31 T 4 N R 5 E
1 miles W of Bet
(distance) (direction) (nearest town)

WELL PURPOSE: none
(home, irrigation, municipal, industrial)

- WELL COMPLETION DATA:
- (1) diameter (inches) 4
 - (2) total depth (feet) 140
 - (3) static water level (feet) 80 ^{below} top of ground.
 - (4) casing Plastic, 1.33' (material) (depth)
 - 4 (size) If telescope see back.
 - (5) screen 7' 1.33' (length) (depth to top)
 - 008, Plastic (size) (material)
 - (6) pump 3/4 7 (HP) (yield gpm)
 - elec (type power)
 - (7) electric log no (yes or no)

CODED

(organization running log)

(8) how well bottom plugged back
snob


NOV 12 1970

DRILLERS REMARKS:

MISS. RD. OF
WATER COM.

If well telescopes please sketch and show depths.

GROUND LEVEL

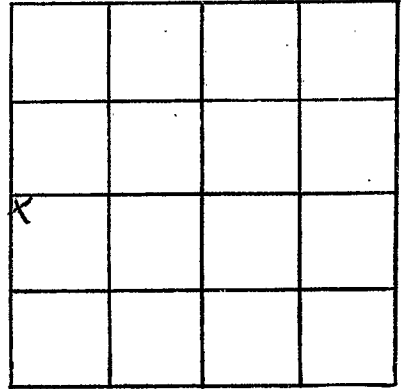

SECTION 31

Please indicate well location X.

ADDITIONAL INFORMATION

If more than one screen, show locations of each on sketch.