

TATE
D32
12-4-70

MISSISSIPPI
BOARD OF WATER COMMISSIONERS
416 North State Street
Jackson, Mississippi 39201

CODED

WATER WELL DRILLERS LOG

12-4-70 19 Jim Renix Tate
date well completed firm name county well located

LANDOWNER: Clarence Mays

description of formations encountered

from to

RFD 3

Coldwater, Ms.
(mailing address)

Dirt	0	10
Sand & Clay	10	90
Mud	90	130
Sand	130	149

WELL LOCATION:

sec. 9 T. 4 R. 5
14 miles East of Coldwater
(distance) (direction) (nearest town)

WELL PURPOSE: Home
(home, irrigation, municipal, industrial)

WELL COMPLETION DATA:

- (1) diameter (inches) 2 & 1/4
- (2) total depth (feet) 149
- (3) static water level (feet) 105 below top of ground.
- (4) casing Galv. 145 Ft.
(material) (depth)
2 & 1/4" if telescope see back.
(size)
- (5) screen 4 Ft. 145 Ft.
(length) (depth to top)
1 1/2" Brass
(size) (material)
- (6) pump 1/2 (HP) 3 (yield gpm)
Elec.
(type power)
- (7) electric log No
(yes or no)
(organization running log)
- (8) how well bottom plugged open

CODED



JAN 25 1971

DRILLERS REMARKS:

MISS. BD. OF
WATER COMMISSIONERS

If well telescopes please sketch and show depths.

GROUND LEVEL

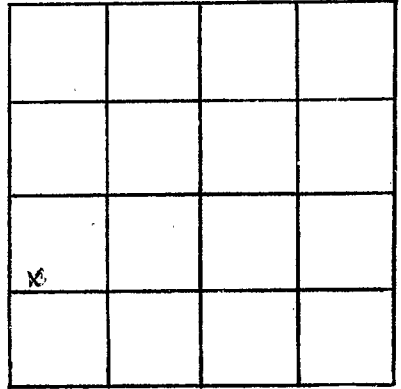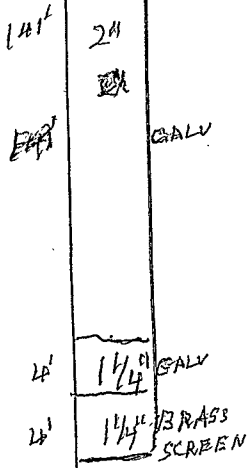

SECTION 9

Please indicate well location X.

ADDITIONAL INFORMATION

If more than one screen, show locations of each on sketch.