

TATE
D34
11-14-70

MISSISSIPPI
BOARD OF WATER COMMISSIONERS
416 North State Street
Jackson, Mississippi 39201
WATER WELL DRILLERS LOG

CODED

11-14-1970 Bob Smith
date well completed firm name county well located

LANDOWNER:
Ray Jones
Wahpet, Miss.
(mailing address)

description of formations encountered	from	to
top soil	0	5
red clay	5	40
red gravel	40	60
white sand	60	120

WELL LOCATION:
sec. 9 T. 4 N. R. 5 E
3 miles east of Wahpet
(distance) (direction) (nearest town)

WELL PURPOSE:
(home, irrigation, municipal, industrial)
Home

WELL COMPLETION DATA:

(1) diameter (inches) 4

(2) total depth (feet) 120

(3) static water level (feet) 60 below top of ground.

(4) casing Plastic, 120 (material), (depth), (size) if telescope see back.

(5) screen 20 (length), 100 (depth to top)

4 (size), Plastic (material)

(6) pump 1/2 (HP), 10 (yield gpm)

Electric (type power)

(7) electric log no (yes or no)

(organization running log)

(8) how well bottom plugged plugged

CODED


MAR 1 - 1971

DRILLERS REMARKS:

MISS. Bd. of WATER COMMISSIONERS

If well telescopes please sketch and show depths.

GROUND LEVEL

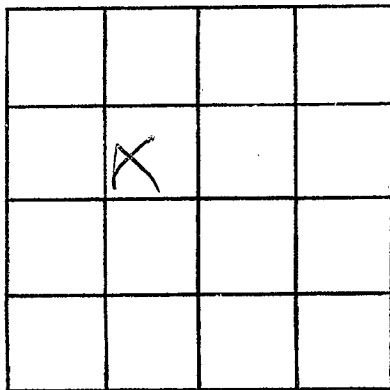

SECTION _____

Please indicate well location X.

ADDITIONAL INFORMATION

If more than one screen,
show locations of each on sketch.